

PIKE

CODED

MISSISSIPPI
 BOARD OF WATER COMMISSIONERS
 416 North State Street
 Jackson, Mississippi 39201

WATER WELL DRILLERS LOG

L-94
 9-29-79

Sept 29 1979
date well completed

Reynolds
firm name

Pike
county well located

LANDOWNER:	description of formations encountered	from	to
Samuel Brunfield Rt. 2500 (mailing address)			
WELL LOCATION: sec. 25 T 1 N R 8 E 7 miles east of Payson (distance) (direction) (nearest town)			
WELL PURPOSE: Tractor (home, irrigation, municipal, industrial)			
WELL COMPLETION DATA:			
(1) diameter (inches) 4"			
(2) total depth (feet) 110			
(3) static water level (feet) 70 below top of ground			
(4) casing plastic bottom (material) (depth)			
(5) screen 5' 105' (length) (depth to top)			
(6) pump 1/2 HP 10 (HP) (yield gpm)			
(7) electric log no (yes or no)			
(8) how well bottom plugged No other plug			
DRILLERS REMARKS:			

CODED


DEPT. OF NATURAL RESOURCES
BUREAU OF LAND & WATER RESOURCES

SEP 2 - 1980

RECEIVED

If well telescopes please sketch and show depths.

GROUND LEVEL

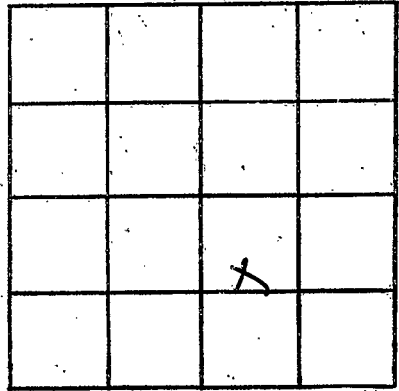

SECTION 25

Please indicate well location X.

ADDITIONAL INFORMATION

If more than one screen, show locations of each on sketch.