

MISSISSIPPI DEPARTMENT OF NATURAL RESOURCES

Bureau of Land and Water Resources

Southport Mall

P.O. Box 10631

Jackson, Mississippi 39209

WATER WELL DRILLERS LOG

L 105
Pike

5-1-85

date well completed

Stephens Water Well

firm name

Pike Co.

county well located

LANDOWNER: David Westhead

Rt. 4.

Magnolia, Ms. 39682
(mailing address)

WELL LOCATION:

sec. 9 T. 1 N. R. 8 E. S. W.
10 miles south of Magnolia
(distance) (direction) (nearest town)

WELL PURPOSE: none
(home, irrigation, municipal, industrial)

WELL COMPLETION DATA:

- (1) diameter (inches) 4 1/2"
- (2) total depth (feet) 107'
- (3) static water level (feet) 84' below top of ground.
- (4) casing plastic, 97' (material) (depth)
- (size) If telescope see back.
- (5) screen 10', 97' (length) (depth to top)
- 4' plastic (size) (material)
- (6) pump 1 1/2 (HP) (yield gpm)
- (type power)
- (7) electric log (yes or no)
- (organization running log)
- (8) how well bottom plugged sand
- sharp

description of formations encountered

from

to

top soil

0 1'

red sand

1' 10'

red chalk

10' 75'

mic gravel

75' 85'

chalk

85' 99'

water sand & gravel

89' 109'

RECEIVED

MAY 9 1985


DRILLERS REMARKS:

Drilled by Curtis Stephens

Department of Natural Resources
Bureau of Land and Water Resources

If well telescopes please sketch and show depths.

GROUND LEVEL

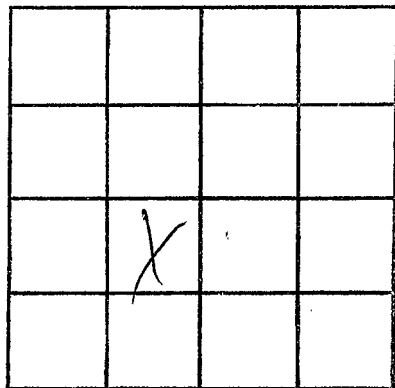

SECTION 9

Please indicate well location X.

ADDITIONAL INFORMATION

If more than one screen,
show locations of each on sketch.