

MISSISSIPPI DEPARTMENT OF NATURAL RESOURCES
 Bureau of Land and Water Resources
 Southport Mall
 P.O. Box 10631
 Jackson, Mississippi 39209
WATER WELL DRILLERS LOG

PIKE
L 106
6-7-85

5-7 1985 F. General and Lewis Pike
 date well completed firm name county well located


LANDOWNER:	description of formations encountered	from	to
<u>Plantation Pipe Line Corp -</u> <u>P.O. Box BAKER La.</u> (mailing address)			
WELL LOCATION: sec. <u>11</u> T- <u>1</u> (N) R- <u>8</u> (E) <u>3</u> miles <u>NW</u> of <u>Progress</u> (distance) (direction) (nearest town)			
WELL PURPOSE: <u>Home - Domestic</u> (home, irrigation, municipal, industrial)			
WELL COMPLETION DATA: (1) diameter (inches) <u>4</u> (2) total depth (feet) <u>155</u> (3) static water level (feet) <u>90</u> below above top of ground. (4) casing <u>PVC</u> <u>135</u> (material) (depth) <u>4</u> if telescope see back. (size) (5) screen <u>20</u> <u>135</u> (length) (depth to top) <u>4</u> <u>PVC</u> (size) (material) (6) pump <u>1 1/2</u> <u>30</u> (HP) (yield gpm) <u>Elco</u> (type power) (7) electric log <u>No</u> (yes or no) (organization running log) (8) how well bottom plugged <u>Sand shell</u>			
DRILLERS REMARKS:			

RECEIVED
 MAY 17 1985

Department of Natural Resources
 Bureau of Land & Water Resources

If well telescopes please sketch and show depths.

GROUND LEVEL

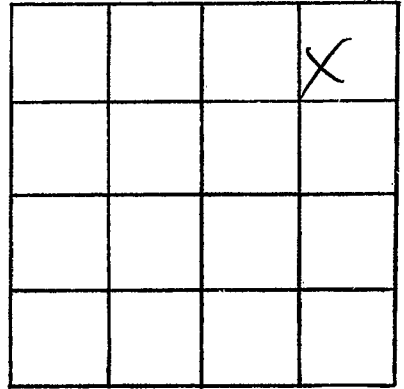

SECTION 11

Please indicate well location X.

ADDITIONAL INFORMATION

If more than one screen,
show locations of each on sketch.