

MISSISSIPPI DEPARTMENT OF NATURAL RESOURCES

Bureau of Land and Water Resources

Southport Mall

P.O. Box 10631

Jackson, Mississippi 39209

WATER WELL DRILLERS LOG

PIKE
L 107
4-5-85

4-5 1985 Filwood Well Log Pike
 date well completed firm name county well located

LANDOWNER:	description of formations encountered	from	to
<u>Tommy King</u>			
<u>Rh. Magnolia ms.</u> (mailing address)	<u>Red Sand</u>	<u>20</u>	<u>90</u>
WELL LOCATION:	<u>Coarse Sandstone</u>	<u>90</u>	<u>114</u>
sec. <u>4</u> T. <u>1</u> (N) S R. <u>8</u> (E) W			
<u>6</u> miles <u>SE</u> of <u>Magnolia</u> (distance) (direction) (nearest town)			
WELL PURPOSE: <u>Flow</u> (home, irrigation, municipal, industrial)			
WELL COMPLETION DATA:			
(1) diameter (inches) <u>4</u>			
(2) total depth (feet) <u>114</u>			
(3) static water level (feet) <u>74</u> below above top of ground.			
(4) casing <u>PVC</u> , <u>104</u> (material) (depth)			
<u>4</u> (size) if telescope see back.			
(5) screen <u>10</u> , <u>104</u> (length) (depth to top)			
<u>4</u> , <u>PVC</u> (size) (material)			
(6) pump <u>1/2</u> , <u>10</u> (HP) (yield gpm)			
<u>Electric</u> (type power)			
(7) electric log <u>no</u> (yes or no)			
<u></u> (organization running log)			
(8) how well bottom plugged <u>See log</u>			
DRILLERS REMARKS:			


RECEIVED

MAY 17 1985

Department of Natural Resources
 Bureau of Land & Water Resources

If well telescopes please
sketch and show depths.

GROUND LEVEL

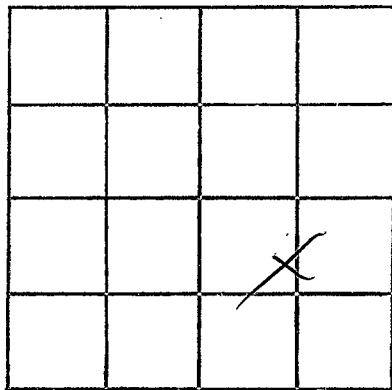

SECTION 4

Please indicate well location X.

ADDITIONAL INFORMATION

If more than one screen,
show locations of each on sketch.