




If well telescopes please sketch and show depths.

GROUND LEVEL

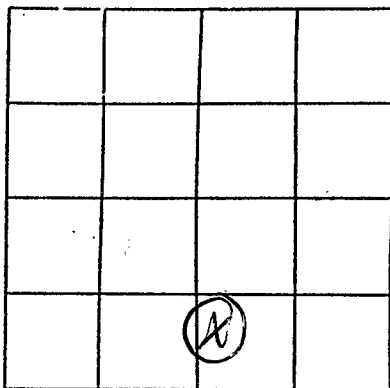

SECTION 31

Please indicate well location X.

Pump Capacity (GPM)	No. of Stages	Setting Depth	
12	8	110'	FT.
PUMP TEST			
Well yielded _____ GPM with a drawdown of _____ ft. after _____ hours of pumping			

LOG DATA

TYPE OF LOG RUN (Circle One):  No Log Run,  Electric,  Gamma Ray,  Density,  Sonic,  Neutron,  Other (Describe) \_\_\_\_\_

Name of Organization Running Log \_\_\_\_\_

GEOLOGIC DATA (Office Use Only)

Surface Elev.	Geologic Unit	Unit Thickness	Depth to Top
Subs. SWL	Date	Analysis	Aquifer Test

Driller's Remarks

---



---



If more than one screen, show location of each on sketch.