State W	ell Report
County: Pike Part 1-1	Driller's Log For Office Use Only:
Mississippi Departmen	nt of Environmental Quality Aquifer:
The interview POI	and Water Resources Box 10631 Well #: $\angle 153$
Jackson M	AS 39289-0631 L. S. Elevation:
Date drilling completed: $417Dc$ (601)	961-5210
(601)35	E-log #:
State Law requires that this report be prepared by the lic Department at the above address within 30 days of comp	ense holder responsible for the work and filed with the poletion of drilling of the well or borehole.
Information on Well Owner (Landowner if borehole is not for a water well)	Well or Borehole Location
Owner Name Wate Warren	Latitude:°' Longitude:°'
Mailing Address: Pile 93	Method of Lat/Long (circle one): Conventional Survey,
	USGS quad, Hand-held GPS, Survey-grade GPS
Chatawa, MS City State Zip Code	<u></u>
	Distance Direction Nearest Town <u>4 Miles</u> <u>F</u> of <u>Chatawa</u>
Telephone No. ()	
Well / Bore	
Date drilling started: 411 De Date drilling completed: 4111	DL Hole depth: 130 Hole diameter: 811
Location of the source of any surface water used for drilling:	
Method of dosing and volume of Chlorine used in drilling and devel	
Logs run (circle all applicable). No log run Electric Gamma Ray Name of organization running log(s):	Density Sonic Neutron Other:
Purpose of borehole (check one): Water Well Geotechnical/Geolo	ogical Investigation Ground Source Heat Pump
Seismic SurveyOther (describe))
Purpose of Well (check one): Home Industrial Public Supply	
If a flowing well, method of flow regulation: Valve O	
Static Water Level:feet above or below (circle one) la	and surface Date measured:
Method of Measurement (circle one) steel tape electric tape	air line other:
	of grout (circle one): Neat Cement) Bentonite Mix
	_inches Type of casing:
Screen length: 10feet Screen diameter: 4	_inches Type of screen:
Screen slot size: • 012_inches Setting depth: From_	
Type of completion (circle all applicable): Gravel packed Underr	eamed Telescoped Open hole Natural Development
Other (describe):	
Top of lap pipe or reduction in casing:feet. If tele	sscoped or more than one screen, describe on next page


т<u>к</u> т

Form: OLWR-SWR-1A

MAY 0 3 2006 BY: OLWR

L-153


The sketch below only required for water wells

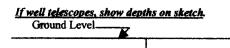

Description of formations encountered must be provided for all wells and boreholes, unless specifically exempted by regulations

Description of Formations Encountered	From (depth)	To (depth)
	Ground Level	
clury,	0	20
Sandtgrad	20	80
clayr	80	100
clury Sand Igraef Clury Sandr Course Sandr	100	120
Course Sand	120	130
		· · · · · · · · · · · · · · · · · · ·
	1	
		+
	1	1

If more than one screen, show location of each on sketch

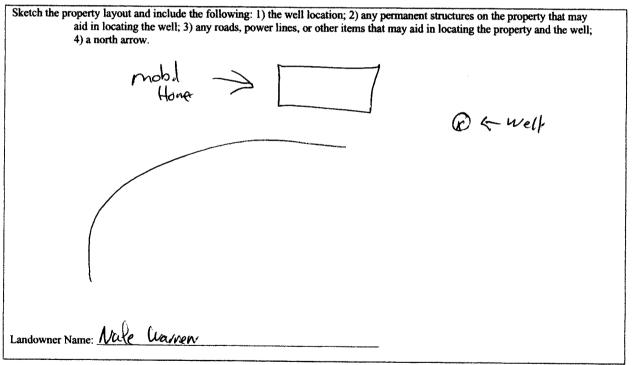

Form: OLWR-SWR-1A

I certify that the well/borehole was drilled, constructed, and completed in accordance with all applicable requirements of the Mississippi Department of Environmental Quality and the Mississippi Department of Health regulations, if applicable, and state

Date

BIAd Fitzerald

029. 4-17-06. Budd

Print Name of Responsible Licensee and License No.

Signature of Licensee

MAY 0 3 2006 BY: OLWR

and at the above address within 20 days of well sould be
nent at the above address within 30 days of well completion. Well Location
Latitude: Longitude: Method of Lat/Long (check one): Conventional Survey USGS quad, Hand-held GPS, Survey-grade GPS 4 4 SecT 4 SecT 4 Distance Direction Nearest Town Miles EASH_of Chuluwq/
Power Type Circle one
Diesel Engine Gasoline Engine Natural Ga
Electric Motor Hand Tractor PTO Windmill Other (specify):
Method of Measuring Water Level Circle one
Air Line Electric Measuring Line Steel Tape Other (specify):
For flowing well, measured shut in head:feet Well yieldedGPM with a drawdown offeet afterhours of pumping

MAY 0 3 2006 BY: OLWR