	Vell Report Driller's Log	For Office Use Only:
Mississippi Departme	ent of Environmental Quality	Aquifer: L 220
Permit #: Office of Land	and Water Resources	•
Driller: Eltzureld Well Sure P.O.	Box 10631	Well #:
	MS 39289-0631	L. S. Elevation:
)961-5210	
(601)3	54-6938 (fax)	E-log #:
State Law requires that this report be prepared by the li	conse halder responsible for i	be work and filed with the
Department at the above address within 30 days of com	pletion of drilling of the well	or borehoie.
Information on Well Owner	Well or Be	rehole Location
(Landowner if borehole is not for a water well)	310 2 13	3 Longitude: 20° 25: 4.5
Owner Name James Guidry.	Latitude: J & J K	J Longitude: $\frac{20}{3}$ $\frac{30}{7}$ $\frac{70}{7}$
Owner Name James Guidry. 1133 Centerville Rob	Method of Lat/Long (circle or	e); Conventional Survey.
Mailing Address: (enfr/VIIIe Rob		
		GPS, Survey-grade GPS
A / .	15W% N2% Sec 20	TWO/N ROB PE
OSTRU MS. City State Zip Code		
City/ State Zip Code	Distance Direction	
Telephone No. ()	MINCS	of
	ehole Data	
Date drilling started 9-28-10 Date drilling completed: 9-28-	10 Hole denth 150-	Hole diameters 811
	How depair 10	Hole unameter.
Location of the source of any surface water used for drilling:		
Method of dosing and volume of Chlorine used in drilling and deve	elopment:	
Logs run (circle all applicable): No log run) Electric Gamma Ray	Density Sonic Neutron	Other:
Name of organization running log(a):		
Purnose of horshole (check one): Water Wall 1		
Purpose of borehole (check one): Water WellGeotechnical/Geo	logical investigation Ground	Source Heat Pump
Seismic Survey Other (describ		1
Charles (material	E)	
If drilling is not related to water well construction	e) ex. skip the remainder of this blo	ck
	en, ship the remainder of this blo	
Purpose of Well (check one): HomeIndustrial Public Suppl	y Irrigation Fish Culture	Other:
Purpose of Well (check one): Home Industrial Public Supply If a flowing well, method of flow regulation: Valve (en. ship the remainder of this blo y Irrigation Fish Culture Dther (describe)	Other:
Purpose of Well (check one): Home Industrial Public Supply If a flowing well, method of flow regulation: Valve (en. ship the remainder of this blo y Irrigation Fish Culture Dther (describe)	Other:
Purpose of Well (check one): Home <u></u>	en. ship the remainder of this blo y Irrigation Fish Culture Other (describe) land surface Date measured:	Other:
Purpose of Well (check one): Home <u>Industrial</u> Public Supple If a flowing well, method of flow regulation: Valve <u>Construction</u> Static Water Level: <u>47</u> feet above or below (circle one) Method of Measurement (circle one) <u>seet uppe</u> electric tape	en. ship the remainder of this blo y Irrigation Fish Culture Other (describe) land surface Date measured: air line other:	 9-2&-10
Purpose of Well (check one): Home Industrial Public Supple If a flowing well, method of flow regulation: Valve (Static Water Level: feet above or below (circle one) Method of Measurement (circle one)	en. ship the remainder of this blo y Irrigation Fish Culture Other (describe) land surface Date measured: air line other:	 9-2&-10
Purpose of Well (check one): Home <u></u>	en. ship the remainder of this blo y Irrigation Fish Culture Other (doscribe) land surface Date measured: air line other: e of grout (circle one): Neat Ceme	 9-24-10 m Bentonite Mix
Purpose of Well (check one): Home <u></u>	en. ship the remainder of this blo y Irrigation Fish Culture Other (describe) land surface Date measured: air line other:	 9-24-10 m Bentonite Mix
Purpose of Well (check one): Home <u></u>	ship the remainder of this blo yIrrigationFish Culture Dther (describe) land surface Date measured: air line other: e of grout (circle one); Neat Centerinches Type of casing:	<u>9-28-70</u> and Bentonite Mix A_C
If drilling is not related to water well construction Purpose of Well (check one): Home Industrial Public Supple If a flowing well, method of flow regulation: Valve (or static Water Level: feet above or below (circle one) Static Water Level: feet above or below (circle one) Method of Measurement (circle one) Static Upple Well depth: 150 Well grouted to a depth of 10 feet Type Casing length: /0 feet Screen length: feet Screen length: feet	en. ship the remainder of this blo yIrrigationFish Culture Dther (describe) land surface Date measured: air line other: e of grout (circle one): Neat Ceme inches Type of casing:	<u>9-28-10</u> <u>n</u> Bentonite Mix A _C <u>2</u> C
If drilling is not related to water well construction Purpose of Well (check one): Home Industrial Public Supple If a flowing well, method of flow regulation: Valve (or static Water Level: feet above or below (circle one) Static Water Level: feet above or below (circle one) Method of Measurement (circle one) Static Upple Well depth: 150 Well grouted to a depth of 10 feet Type Casing length: /0 feet Screen length: feet Screen length: feet	en. ship the remainder of this blo yIrrigationFish Culture Dther (describe) land surface Date measured: air line other: e of grout (circle one): Neat Ceme inches Type of casing:	<u>9-28-10</u> <u>n</u> Bentonite Mix A _C <u>2</u> C
If drilling is not related to water well construction Purpose of Well (check one): Home Industrial Public Supplic If a flowing well, method of flow regulation: Valve (Construction) Static Water Level: feet above or below (circle one) Method of Measurement (circle one) Secture of the supervision of t	en. ship the remainder of this blo yIrrigationFish Culture Dther (describe) land surface Date measured: air line other: e of grout (circle one): Neat Ceme inches Type of casing: inches Type of screen: IUUfeet to5	 <u>9-24-10</u> <u>an</u> Bentonite Mix <u>A</u> <u>c</u> <u>2</u> <u>c</u> <u>6</u> <u>feet</u>
If drilling is not related to water well construction Purpose of Well (check one): Home Industrial Public Supplic If a flowing well, method of flow regulation: Valve (Construction) Static Water Level: feet above or below (circle one) Method of Measurement (circle one) Secture of the supervision of t	en. ship the remainder of this blo yIrrigationFish Culture Dther (describe) land surface Date measured: air line other: e of grout (circle one): Neat Ceme inches Type of casing:	 9-24-10 Dentonite Mix A_C 20C 0fcet
If drilling is not related to water well construction Purpose of Well (check one): Home Industrial Public Supplic If a flowing well, method of flow regulation: Valve (Construction) Static Water Level: feet above or below (circle one) Method of Measurement (circle one) Secture of the supervision of t	en. ship the remainder of this blo yIrrigationFish Culture Dther (describe) land surface Date measured: air line other: e of grout (circle one): Neat Ceme inches Type of casing: inches Type of screen: IUUfeet to treamed Telescoped Open t	 <u>9-24-10</u> <u>an</u> Bentonite Mix <u>A</u> <u>c</u> <u>2</u> <u>c</u> <u>6</u> <u>feet</u>
If drilling is not related to unter well construction Purpose of Well (check one): Home Industrial Public Supple If a flowing well, method of flow regulation: Valve (construction) Static Water Level: feet above or below (circle one) Method of Measurement (circle one) Method of Measurement (circle one) Stell apple Well depth: 150 ⁻ Well grouted to a depth of 10 ⁻ Casing length: 140 ⁻ feet Screen length: 10 ⁻ feet Screen slot size: 012 inches Setting depth: From	en. ship the remainder of this blo yIrrigationFish Culture Dther (describe) land surface Date measured: air line other: e of grout (circle one): Neat Ceme inches Type of casing: inches Type of screen: feet to Type of casing the screen of the screen	Other: 9-2&-/c m Bentonite Mix A_c 2 0feet nole Natural Development
If drilling is not related to water well construction Purpose of Well (check one): Home Industrial Public Supple If a flowing well, method of flow regulation: Valve (construction) Static Water Level: feet above or below (circle one) Method of Measurement (circle one) Method of Measurement (circle one) Stell apple Well depth: /0 feet Casing length: /0 feet Screen length: /0 feet Screen slot size: (circle all applicable): Castrid Completion (circle all applicable): Castrid Completion (circle all applicable):	en. ship the remainder of this blo yIrrigationFish Culture Dther (describe) land surface Date measured: air line other: e of grout (circle one): Neat Ceme inches Type of casing: inches Type of screen: feet to Type of casing the screen of the screen	Other: 9-2&-/c m Bentonite Mix A_c 2 0feet nole Natural Development
If drilling is not related to unter well construction Purpose of Well (check one): Home Industrial Public Supple If a flowing well, method of flow regulation: Valve (construction) Static Water Level: feet above or below (circle one) Method of Measurement (circle one) Method of Measurement (circle one) Stell apple Well depth: 150 ⁻ Well grouted to a depth of 10 ⁻ Casing length: 140 ⁻ feet Screen length: 10 ⁻ feet Screen slot size: 012 inches Setting depth: From	en. ship the remainder of this blo yIrrigationFish Culture Dther (describe) land surface Date measured: air line other: e of grout (circle one): Neat Ceme inches Type of casing: inches Type of screen: feet to Type of casing the screen of the screen	Other: 9-24-10 Dentonite Mix A_C 20 0feet nole Natural Development
If drilling is not related to water well construction Purpose of Well (check one): Home Industrial Public Supple If a flowing well, method of flow regulation: Valve (construction) Static Water Level: feet above or below (circle one) Method of Measurement (circle one) Method of Measurement (circle one) Stell apple Well depth: /0 feet Casing length: /0 feet Screen length: /0 feet Screen slot size: (circle all applicable): Castrid Completion (circle all applicable): Castrid Completion (circle all applicable):	en. ship the remainder of this blo yIrrigationFish Culture Dther (describe) land surface Date measured: air line other: e of grout (circle one): Neat Ceme inches Type of casing: inches Type of screen: feet to Type of casing the screen of the screen	Other: 9-2.6-7.0 a) Bentonite Mix A.c 9.c 0feet nole Natural Development Litereribe on next pare Form: OLWR-SWR-1A
If drilling is not related to unter well construction Purpose of Well (check one): Home Industrial Public Supple If a flowing well, method of flow regulation: Valve (construction) Static Water Level: feet above or below (circle one) Method of Measurement (circle one) Method of Measurement (circle one) Stell apple Well depth: 150 ⁻ Well grouted to a depth of 10 ⁻ Casing length: 140 ⁻ feet Screen length: 10 ⁻ feet Screen slot size: 012 inches Setting depth: From	en. ship the remainder of this blo yIrrigationFish Culture Dther (describe) land surface Date measured: air line other: e of grout (circle one): Neat Ceme inches Type of casing: inches Type of screen: feet to Type of casing the screen of the screen	Other: 9-2.6-7.0 a) Bentonite Mix A.c 9.c 0feet nole Natural Development Litereribe on next pare Form: OLWR-SWR-1A
If driffing is not related to water well construction Purpose of Well (check one): Home Industrial Public Supplication: Valve (or static Water Level: feet above or below (circle one) Static Water Level: feet above or below (circle one) Method of Measurement (circle one) Static Under the static type Well depth: 150^- Well grouted to a depth of 10^- feet Type Casing length: /0^ feet Screen length: (or circle all applicable): Circle all applicable):	en. ship the remainder of this blo yIrrigationFish Culture Dther (describe) land surface Date measured: air line other: e of grout (circle one): Neat Ceme inches Type of casing: inches Type of screen: feet to Type of casing the screen of the screen	Other: 9-24-10 Dentonite Mix A_C 20 0feet Natural Development Leaseribe on next page
If drilling is not related to water well construction Purpose of Well (check one): Home Industrial Public Supple If a flowing well, method of flow regulation: Valve (construction) Static Water Level: feet above or below (circle one) Method of Measurement (circle one) Method of Measurement (circle one) Stell apple Well depth: /0 feet Casing length: /0 feet Screen length: /0 feet Screen slot size: (circle all applicable): Castrid Completion (circle all applicable): Castrid Completion (circle all applicable):	en. ship the remainder of this blo yIrrigationFish Culture Dther (describe) land surface Date measured: air line other: e of grout (circle one): Neat Ceme inches Type of casing: inches Type of screen: feet to Type of casing the screen of the screen	Other: 9-2.6-10 a) Bentonite Mix A_C 20C 0feet nole Natural Development Accortibe on next pare Form: OLWR-SWR-1A
If drilling is not related to water well construction Purpose of Well (check one): Home Industrial Public Supple If a flowing well, method of flow regulation: Valve (construction) Static Water Level: feet above or below (circle one) Method of Measurement (circle one) Method of Measurement (circle one) Stell apple Well depth: /0 feet Casing length: /0 feet Screen length: /0 feet Screen slot size: (circle all applicable): Castrid Completion (circle all applicable): Castrid Completion (circle all applicable):	en. ship the remainder of this blo yIrrigationFish Culture Dther (describe) land surface Date measured: air line other: e of grout (circle one): Neat Ceme inches Type of casing: inches Type of screen: feet to Type of casing the screen of the screen	Other: 9-21-70 Dentonite Mix Ac 20 0feet nole Natural Development describe on next pare Form: OLWR-SWR-1A RECENCE OCT 0 6 2010
If drilling is not related to under well construction Purpose of Well (check one): Home Industrial Public Supplication: Valve O If a flowing well, method of flow regulation: Valve O Static Water Level: feet above or below (circle one) Method of Measurement (circle one) Method of Measurement (circle one) Static Water Level: feet above or below (circle one) Method of Measurement (circle one) Static Well grouted to a depth of feet Casing length: feet	en. ship the remainder of this blo yIrrigationFish Culture Dther (describe) land surface Date measured: air line other: e of grout (circle one): Neat Ceme inches Type of casing: inches Type of screen: feet to Type of casing the screen of the screen	

و الحديدية. مندق

¢

.

If well telescopes, show de

Ground Level_


lls and boreholes, unless specifically exempted by regulations

To (depth)

pths on sketch.		
	Description of Formations Encountered	From (depth)
		Ground Lev
	Cluyr	0
	church	20
	Sand	60
	(lug)	80
	Sund	120
	(use Sand	140

221 round Level Ô 20 60 n 80 0 20 80 40 20 140 150

If more than one screen, show location of each on sketch

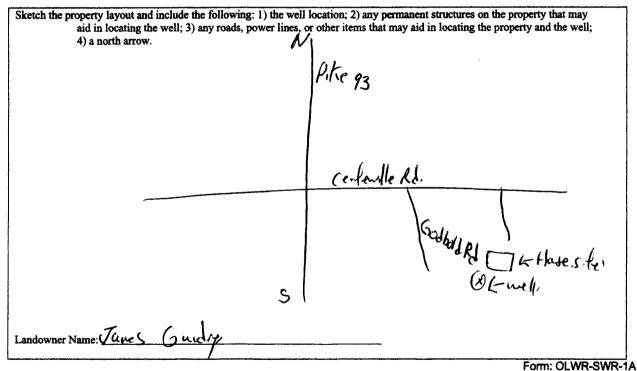

I certify that the well/borehole was drilled, constructed, and completed in accordance with all applicable requirements of the Mississippi Department of Environmental Quality and the Mississippi Department of Health regulations, if applicable, and state

laws Filzial

9-28-10- Bal My ODGr

Signature of Licensee



Print Name of Responsible Licensee and License No. Date

	ΤΙΙ DEDODT
	For Office Use Only:
D t	r's Completion Report Aquifer:
	ent of Environmental Quality
Driller: <u>Fif 2 rel 10 Well Arm</u> , P.O	0. Box 2309 Well #:
	on, MS 39225 Elevation:
	661-5228 (fax)
This part of the report must be completed by a licensed water well	
report must be attached and both parts filed with the Department Well Owner Information	at the above address within 30 days of well completion. Well Location
and Name Termes Guiday.	Latitude 31° 2 17.3 Longitude: 90° 25 4.5"
Owner Name: Tunes Guidy. 1133 Centerile Kd	
Mailing Address: (Enternite Not	Method of Lat/Long (check one): Conventional Survey,
	USGS quad, Hand-held GPS, Survey-grade GPS
OJ/Ka MS. City State Zip Code	<u>14 Sec 20 T_IN_R&E</u>
City' State Zip Code	Distance Direction Nearest Town
Telephone No. ()	Miles of
Pump Type	Power Type
Circle one Air Lift Jet Submersible	Circle one Diesel Engine Gasoline Engine Natural Gas
Bucket Piston Turbine	Electric Motor Hand Tractor PTO
Centrifugal Rotary Flowing Well	Windmill Other (specify):
Other (specify):	Horse Power Rating of Motor:
	-
Date Pump Installed: <u>9-28-10.</u>	Setting Depth:feet
Rated Pump Capacity:Gallons Per Minute	Number of Stages: <u>12</u> .
Pump Test Data	Method of Measuring Water Level
Date Well Tested:	Circle one
Static Water Level (A):Feet Below Land Surface	Air Line Electric Measuring Line Steel Tape
Pumping Water Level (B):Feet Below Land Surface	Other (specify):
Drawdown [(B) - (A)]:Feet Below Land Surface	For flowing well, measured shut in head:feet
Test Pumping Rate:Gallons Per Minute	Well yieldedGPM with a drawdown of
Duration of Pump Test (minimum 4 hours):hours	feet afterhours of pumping
This is for (circle one): New Well Replacement of Ex	xisting Pump Repair of Existing Pump
I HEREBY CERTIFY that the above statements are true to the best	of my knowledge.
Biad Flara d. Ber	Rad title
Print Name of Pump Installer and License No. (if applicable)	Signature of Pump Installer
	Form: OLWR-SWP 16 (07 09)
	OCT 0 6 20
	BYOLM

er de la composition El composition de la c