

STATE WELL REPORT

Part 1

Driller's Log

Mississippi Department of Environmental Quality
Office of Land and Water Resources
P.O. Box 2309
Jackson, MS 39225-2309
(601)561-5210
(601)360-0535 (fax)

For Office Use Only:

Well #: L 258
Aquifer: _____
E-Log #: _____

County: Pike
Permit #: _____
Driller: James M. Wells
Date drilling completed: 10-2-18

State Law requires that this report be prepared by the license holder responsible for the work and filed with the Department at the above address within 30 days of completion of drilling of the well or borehole.

Well Owner Information (Landowner if borehole is not for a water well)	Well or Borehole Location
Owner Name: <u>Fulcrum Construction</u>	Latitude: <u>31°04.34N</u> Longitude: <u>90°21.53W</u> <u>31-04-36</u> <u>90-21-51</u>
Mailing Address: <u>805 Priore Ave</u> <u>Daphne AL 36526</u>	Method of Lat/Long (check one): Conventional Survey _____ USGS quad _____, Hand-held GPS _____, Survey-grade GPS _____ <u>SE</u> 1/4 <u>SE</u> 1/4, Sec <u>2</u> T. <u>1N</u> R. <u>8E</u>
City: _____ State: _____ Zip Code: _____	Miles _____ of _____ (Distance) (Direction) (Nearest Town)
Telephone No. (_____) _____	

Well / Borehole Data

Date drilling started: 10-2-18 Date drilling completed: 10-2-18 Hole depth: 1160' Hole diameter: 10 in.

Location of the source of any surface water used for drilling: standing creek

Method of dosing and volume of Chlorine used in drilling and development: granule chlorine

Logs run (circle all applicable): No log run Electric Gamma Ray Density Sonic Neutron Other: _____

Name of organization running log(s): _____

Purpose of borehole (circle one): Water Well Geotechnical/Geological Investigation Ground Source Heat Pump
 Seismic Survey Other (describe) _____

If drilling is not related to water well construction, skip the remainder of this block

Purpose of Well (circle all applicable): Home Industrial Public Supply Irrigation Fish Culture
 Other (describe): rest room water supply

If a flowing well, method of flow regulation: Valve _____ Other (describe) _____

Static Water Level: 80 feet (above or below land surface) (circle one) Date measured: 10-2-18

Method of measurement (circle one): Steel tape Electric tape Air line Other (describe): _____

Well depth: 1160 Well grouted to a depth of: 120 feet Type of grout (circle one): Neat Cement Bentonite Mix

Casing length: 140 feet Casing diameter: 4 inches Type of casing: PVC

Screen length: 20 feet Screen diameter: 4 inches Type of screen: PVC

Screen slot size: .008 inches Setting depth: From 140 feet to 1160 feet

Type of completion (circle all applicable): Gravel packed Underreamed Open hole Natural Development

Other (describe): _____

Top of lap pipe or reduction in casing: _____ feet

If telescoped or more than one screen, describe on next page


County: Pike
 Permit #: _____

For Office Use Only:
 Well #: L258

The sketch below only required for water wells

Description of formations encountered must be provided for all wells and boreholes, unless specifically exempted by regulations

If well telescopes, show depths on sketch.

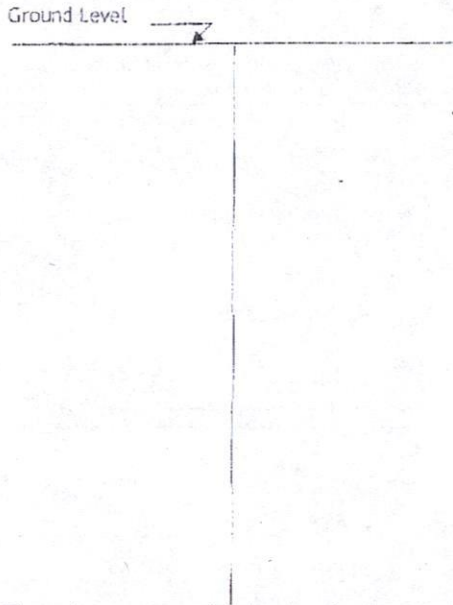

Description of Formations Encountered	From (depth)	To (depth)
topsoil	Ground level	1
Clay	1	15
Sand & gravel	15	40
Gravel	40	160

If more than one screen, show location of each on sketch

Sketch the property layout and include the following:

- 1) the well location
- 2) any permanent structures on the property that may aid in locating the well
- 3) any roads, power lines, or other items that may aid in locating the property and the well
- 4) north arrow

Landowner Name: Fulcrum Construction

I HEREBY CERTIFY that the well/borehole was drilled, constructed, and completed in accordance with all applicable requirements of the Mississippi Department of Environmental Quality and the Mississippi Department of Health regulations, if applicable, and state laws.

James M. Wells 0005889 11-1-18 James M. Wells
 Print Name of Responsible Licensee and License No. Date Signature of Licensee

STATE WELL REPORT

Part 2

Pump Installer's Completion Report
 Mississippi Department of Environmental Quality
 Office of Land and Water Resources
 P.O. Box 2309
 Jackson, MS 39225-2309
 (601) 961-5210
 (601) 360-0535 (fax)

County: Pike
 Permit #: _____
 Driller: James M. Wells
 Date completed: 10-2-18
Copy information from block on Part 1

For Office Use Only:
 Well #: L258
 Aquifer: _____

This part of the report must be completed by a licensed water well contractor or a licensed pump installer. A copy of Part 1 of the report must be attached and both parts filed with the Department at the above address within 30 days of well completion.

Well Owner Information		Well Location	
Owner Name: <u>Federum Construction</u>	Latitude: <u>31°04.34N</u>	Longitude: <u>90°21.53W</u>	
Mailing Address: _____	Method of Lat/Long (check one): <u>31-04-36</u>	<u>90-21-51</u>	
<u>805 Prairie Ave</u>	USGS quad _____	Hand-held GPS _____	Survey-grade GPS _____
<u>Daphne</u> <u>AL</u> <u>36526</u>	<u>SE</u> 1/4 <u>SE</u> 1/4, Sec <u>2</u>	<u>T. 1N</u>	<u>R. 8E</u>
City State Zip Code	_____ miles _____ of _____	(Distance)	(Direction) (Nearest Town)
Telephone No. (____) _____			

Pump Type (circle one)
 Submersible Turbine Air lift Centrifugal Flowing Well Jet Piston Rotary Other (describe): _____
 Date Pump Installed: 10-2-18 Rated Pump Capacity: 18 Gallons Per Minute
 Is This Pump (circle one): New Repaired Replacement

Power Type (circle one)
 Electric Diesel Gasoline Natural Gas Tractor PTO Windmill Other (describe): _____
 Horse Power Rating of Motor: 1 Setting Depth: 100 feet Number of Stages: 10

Pump Test Data for Non Flowing Well
 Date Well Tested: 10-2-18 Duration of Pump Test (minimum 4 hours): 4 hours
 Static Water Level (A): 80 Feet Below Land Surface Pumping Water Level (B): 100 Feet Below Land Surface
 Drawdown [(B) - (A)]: 90 Feet Below Land Surface Test Pumping Rate: 25 Gallons Per Minute
 Method of measurement (circle one): Steel tap Electric tape Air Line Other (describe): _____

Pump Test Data for Flowing Well
 Measured shut in head: _____ feet.
 Well yielded _____ GPM with a drawdown of _____ feet after _____ hours of pumping

Meter Installation
 Meter Manufacturer: _____ Meter Serial Number: _____
 Meter Model Number/Name: _____ Type of Meter: _____
 Totalizer Register Unit and Multiplier Factor (AF x .001, ga. x 1000, etc): _____
 Installation Date: _____ Meter installed by: _____
 Is This Meter (circle one): New Repaired Replacement
Important: By submitting the above information you are certifying that this meter was installed to manufacturer standards. For agricultural wells, a list of approved meters is on the MDEQ website.

I HEREBY CERTIFY that the above statements are true to the best of my knowledge.
James M. Wells 00005889 11-1-18 James M. Wells
 Print Name of Pump Installer and License No. (if applicable) Date Signature of Pump Installer