	STATE W	ELL REPORT	323
Permit #: Driller: <u>FclZycald Well &/wee</u> Date drilling completed: <u>1-15-19</u>	Drill Nississippi Departmer Office of Land P.O. Jackson, (601)90	Part 1 ler's Log it of Environmental Qualit and Water Resources Box 2309 MS 39225-2309)961-5555 j1-5228 (fax)	Aquifer: E-Log #:
State Law requires that this report be Department at the above address with	preparea by the uce in 30 days of compl	etion of drilling of the we	ll or borehole.
Well Owner Information (Landowner if borehole is not for a solution Owner Name: <u></u>	water well)	ntitude: <u>31⁶4</u> 26,9 ⁴ ethod of Lat/Long (<i>check o</i> SGS quad, Hand-helo SE <u>14</u> SE 4, Se	brehole Location Longitude: $\underline{90^{\circ} 21^{\prime} 56.2^{\prime\prime}}$ pre): Conventional Survey, d GPS, Survey-grade GPS $c_2 \underline{2}^{\prime} T_1 \underline{N}^{\prime} R_2 \underline{8E}^{\prime}$
Telephone No. ()	-	Miles Distance) (Direction	_ of) (Nearest Town)
Location of the source of any surface wat Method of dosing and volume of Chlorine Logs run (check all applicable): Cog run Name of organization running log(s): Purpose of borehole (check one): Water W	used in drilling and Electric Gamma Vell Geotechnica	development: Ray Density Sonic New /Geological Investigation	utron Other: Ground Source Heat Pump
If drilling is not relate	ed to water well con	struction, skip the remain	der of this block RECEIVE
Purpose of Well (check all applicable):	Home Industrial	_Public Supply[]irrigatio	BY OLW
Method of measurement (check one) \mathbb{P} is well depth: 70^{\prime} Well grouted to a discrete length: 95^{\prime} feet Cassis Screen length: 10^{\prime} feet Screen slot size: 810^{\prime} inches Type of completion (check all applicable) \mathbb{P}	teel tape Electric ta lepth of: <u>/ 0</u> fee sing diameter: <u>4</u> reen diameter: <u>4</u> Setting depth: 1) Fravel packed	pe Air line Other (<i>desci</i> t Type of grout (<i>c</i> heck o <u>''</u> inches Type <u>Y</u> inches Type From <u>95</u> fee Underreamed Open h	ribe): ne) Neat Cement Bentonite Mix of casing: e of screen: t tofeet
Top of lap pipe or reduction in casing: _	feet	e screen, describe on nex	t page

T


County:	
Permit #:	

For Office	Use	Only:
------------	-----	-------

Well #: 1260

The sketch below only required for water wells

If well telescopes, show depths on sketch.

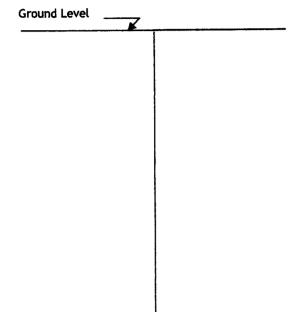

Description of formations encountered must be provided for all wells and boreholes, unless specifically exempted by regulations

Description of Formations Encountered	From (depth)	To (depth)
	Ground level	
cluy	0	20
Sand.	20	ho
clus	60	8-0
Sault	80	90
Course Sand	90	105

.

If more than one screen, show location of each on sketch

Sketch the property layout and include the following:

1) the well location

2) any permanent structures on the property that may aid in locating the well

3) any roads, power lines, or other items that may aid in locating the property and the well

4) north arrow

Landowner Name:

I HEREBY CERTIFY that the well/borehole was drilled, constructed, and completed in accordance with all applicable requirements of the Mississippi Department of Environmental Quality and the Mississippi Department of Health regulations, if applicable, and state laws.

BIAZ Externald,	024.	1-15-19	Bu Untel	
Print Name of Responsible Licens	ee and License No.	Date	Signature o	
			•	

Form: OLWR-SWR-1B (4/13)

Gogle Maps 31°04'26.9"N 90°21'56.2"W



Imagery ©2019 Google, Map data ©2019 Google 100 ft

RECEIVED MAR 0 8 2019 BY OLWR

STATE W	ELL REPORT	
County: Pile	Part 2	For Office Use Only:
Permit #: Pump Installe	er's Completion Report nent of Environmental Quality	Well #: 1131260
Driller: Pitcarald Well Strong Office of La	nd and Water Resources	Wull #
An 1-15-19	P.O. Box 2309 on, MS 39225-2309	Aquifer:
Copy information from block on Part 1	601)961-5210	
(0) This part of the report must be completed by a licensed wate of the report must be attached and both parts filed with the l) 360-0535 (fax) r well contractor or a licensed put Department at the above address y	np installer. A copy of Part 1 within 30 days of well completion.
Well Owner Information	Well L	ocation
Owner Name: Jee Bit Ner	Latitude: 31° 4' 26 9" Lor	gitude: <u> 90° 21' 56.2 #</u>
Mailing Address: Emerald Slute live Rd.	Method of Lat/Long (check one): Conventional Survey,
	USGS quad, Hand-held G	PS, Survey-grade GPS
Tiogicus MS City State Zip Code	SE V SE V, Sec	2 TIN RSE
City State Zip Code	Miles 0	f
Telephone No. ()	(Distance) (Direction)	f(Nearest Town)
	pe (check one)	
Submersible	Jet Piston Rotary Other (de	escribe):
Date Pump Installed: 10-15-19	Rated Pump Capacity:2	Gallons Per Minute
Is This Pump (check one): [] New Repaired Replacement	ent	
	/pe (check <i>one</i>)	
		_
Horse Power Rating of Motor: Setting Dep	oth:feet Number	r of Stages:
Pump Test Data	for Non Flowing Well	
Pump Test Data Date Well Tested:	-	num 4 hours): hours
	Duration of Pump Test (minin	num 4 hours): hours Feet Below Land Surface
Date Well Tested:	Duration of Pump Test (minin Pumping Water Level (B):	
Date Well Tested: Feet Below Land Surface Static Water Level (A): Feet Below Land Surface Drawdown [(B) - (A)]:Feet Below Land Sur Method of measurement (check one): Steel tape Electric	Duration of Pump Test (minin e Pumping Water Level (B): rface Test Pumping Rate: tape 🛛 Air line 🗋 Other (describe):	Feet Below Land Surface Gallons Per Minute
Date Well Tested: Feet Below Land Surface Static Water Level (A): Feet Below Land Surface Drawdown [(B) - (A)]:Feet Below Land Sur Method of measurement (check one): Steel tape Electric	Duration of Pump Test (minin e Pumping Water Level (B): rface Test Pumping Rate:	Feet Below Land Surface Gallons Per Minute
Date Well Tested: Feet Below Land Surface Static Water Level (A): Feet Below Land Surface Drawdown [(B) - (A)]: Feet Below Land Sur Method of measurement (check one): Steel tape Electric Pump Test D Measured shut in head:feet.	Duration of Pump Test (minin e Pumping Water Level (B): rface Test Pumping Rate: tape Air line Other (describe): ata for Flowing Well	Feet Below Land Surface Gallons Per Minute
Date Well Tested: Feet Below Land Surface Static Water Level (A): Feet Below Land Surface Drawdown [(B) - (A)]: Feet Below Land Sur Method of measurement (check one): Steel tape [Electric Pump Test D	Duration of Pump Test (minin e Pumping Water Level (B): rface Test Pumping Rate: tape Air line Other (describe): ata for Flowing Well	Feet Below Land Surface Gallons Per Minute
Date Well Tested: Feet Below Land Surface Static Water Level (A): Feet Below Land Surface Drawdown [(B) - (A)]: Feet Below Land Surface Method of measurement (check one): Steel tape Electric Pump Test D Measured shut in head:feet. Well yielded GPM with a drawdown of Meter	Duration of Pump Test (mining e Pumping Water Level (B): rface Test Pumping Rate:	Feet Below Land Surface Gallons Per Minute
Date Well Tested: Feet Below Land Surface Static Water Level (A): Feet Below Land Surface Drawdown [(B) - (A)]: Feet Below Land Surface Method of measurement (check one): Steel tape Electric Pump Test D Measured shut in head:feet. Well yielded GPM with a drawdown of Meter Manufacturer:	Duration of Pump Test (mininge Pumping Water Level (B):	Feet Below Land Surface Gallons Per Minute
Date Well Tested: Feet Below Land Surface Static Water Level (A): Feet Below Land Surface Drawdown [(B) - (A)]: Feet Below Land Surface Method of measurement (check one): Steel tape Electric Pump Test D Measured shut in head:feet. Well yielded GPM with a drawdown of Meter	Duration of Pump Test (mininge Pumping Water Level (B):	Feet Below Land Surface Gallons Per Minute
Date Well Tested: Feet Below Land Surface Static Water Level (A): Feet Below Land Surface Drawdown [(B) - (A)]: Feet Below Land Surface Method of measurement (check one): Steel tape Electric Pump Test D Measured shut in head:feet. Well yielded GPM with a drawdown of Meter Manufacturer:	Duration of Pump Test (mininge Pumping Water Level (B):	Feet Below Land Surface Gallons Per Minute
Date Well Tested: Feet Below Land Surface Static Water Level (A): Feet Below Land Surface Drawdown [(B) - (A)]: Feet Below Land Sur Method of measurement (check one): Steel tape [Electric Pump Test D Measured shut in head:feet. Well yielded feet. Well yielded GPM with a drawdown of Meter Manufacturer: Meter Manufacturer: Meter Model Number/Name: Totalizer Register Unit and Multiplier Factor (AF x .001, g Installation Date: Meter installed by	Duration of Pump Test (mininge Pumping Water Level (B):	Feet Below Land Surface Gallons Per Minute
Date Well Tested: Feet Below Land Surface Static Water Level (A): Feet Below Land Surface Drawdown [(B) - (A)]: Feet Below Land Surface Method of measurement (check one): Steel tape [Electric Pump Test D Measured shut in head:feet. Well yielded feet. Well yielded GPM with a drawdown of Meter Manufacturer: Meter Model Number/Name: Totalizer Register Unit and Multiplier Factor (AF x .001, g	Duration of Pump Test (mininge Pumping Water Level (B):	Feet Below Land Surface Gallons Per Minute
Date Well Tested: Feet Below Land Surface Static Water Level (A): Feet Below Land Surface Drawdown [(B) - (A)]: Feet Below Land Sur Method of measurement (check one): Steel tape [Electric Pump Test D Measured shut in head:feet. Well yielded GPM with a drawdown of Meter Manufacturer: Meter Manufacturer: Meter Model Number/Name: Totalizer Register Unit and Multiplier Factor (AF x .001, g Installation Date: Meter installed by	Duration of Pump Test (mininge Pumping Water Level (B):	Feet Below Land Surface Gallons Per Minute
Date Well Tested: Feet Below Land Surface Static Water Level (A): Feet Below Land Surface Drawdown [(B) - (A)]: Feet Below Land Surface Method of measurement (check one): Steel tape [Electric Pump Test D Measured shut in head:feet. Well yielded feet. Well yielded GPM with a drawdown of Meter Manufacturer: Meter Manufacturer: Meter Model Number/Name: Totalizer Register Unit and Multiplier Factor (AF x .001, g Installation Date: Meter installed by Is This Meter (check one): New Repaired Replacer	Duration of Pump Test (mininge Pumping Water Level (B):	Feet Below Land Surface Gallons Per Minute
Date Well Tested: Feet Below Land Surface Static Water Level (A): Feet Below Land Surface Drawdown [(B) - (A)]: Feet Below Land Surface Method of measurement (check one): Steel tape [Electric Pump Test D Measured shut in head:feet. Well yielded feet. Well yielded GPM with a drawdown of Meter Manufacturer: Meter Model Number/Name: Totalizer Register Unit and Multiplier Factor (AF x .001, g Installation Date: Meter installed by Is This Meter (check one): New Repaired Replaced Important: By submitting the above information you are Totalizer Wells, d list of a	Duration of Pump Test (mining Pumping Water Level (B):	Feet Below Land Surface Gallons Per Minute

.

۰.

Form: OLWR-SWR-2A (4/13)