

PIKE
L 2000
12-12-75

MISSISSIPPI
BOARD OF WATER COMMISSIONERS
416 North State Street
Jackson, Mississippi 39201

WATER WELL DRILLERS LOG

Dec. 12 1975 *Winnell Service* *Pike*
date well completed firm name county well located

LANDOWNER:
Henry Dixon
Rt. 2, Osage
(mailing address)

description of formations encountered	from	to
<i>Red Clay</i>	<i>0</i>	<i>22</i>
<i>Red Sand</i>	<i>22</i>	<i>45</i>
<i>pink Chalk</i>	<i>45</i>	<i>75</i>
<i>lumpy sand</i>	<i>75</i>	<i>98</i>
<i>sandy gravel</i>	<i>98</i>	<i>115</i>

WELL LOCATION:
sec *30* T *1* N R *8* E
2 1/2 miles *N-NE* of *OSAGE*
(distance) (direction) (nearest town)

WELL PURPOSE: *home*
(home, irrigation, municipal, industrial)

- WELL COMPLETION DATA:
- (1) diameter (inches) *4"*
 - (2) total depth (feet) *115*
 - (3) static water level (feet) *50* below top of ground
 - (4) casing *plastic bottom*
(material) (depth)
 - 6"* If telescope see back.
(size)
 - (5) screen *6"* *109'*
(length) (depth to top)
 - 4"* *plastic*
(size) (material)
 - (6) pump *1/2* *Atlas*
(HP) (yield gpm)
 - elect*
(type power)
 - (7) electric log *no*
(yes or no)
 - (organization running log)


(8) how well bottom plugged
Washed by

DRILLERS REMARKS:
new house

RECEIVED
MAR 8 1976

If well telescopes please sketch and show depths.

GROUND LEVEL

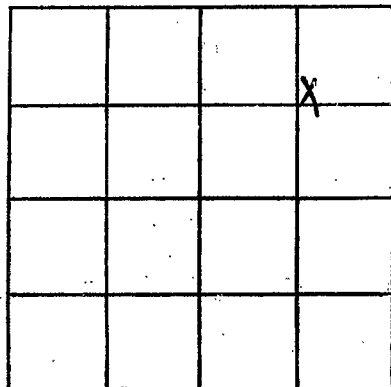

SECTION 30

Please indicate well location X.

ADDITIONAL INFORMATION

If more than one screen, show locations of each on sketch.