

Pike
 L 2001
 5/6/76

MISSISSIPPI
 BOARD OF WATER COMMISSIONERS
 416 North State Street
 Jackson, Mississippi 39201

WATER WELL DRILLERS LOG

May 6 1976 Reverwell Ser Pike
 date well completed firm name county well located

LANDOWNER:
Jimmy Stewart
Rt. 2, Osyka Miss
 (mailing address)

description of formations encountered	from	to
<u>Red Clay</u>	<u>0</u>	<u>20</u>
<u>Red Sand</u>	<u>20</u>	<u>85</u>
<u>pea gravel sand</u>	<u>85</u>	<u>107</u>


WELL LOCATION:
 sec. 26 T. 1 N. R. 8 E
3 miles W.S.W. of Progre
 (distance) (direction) (nearest town)

WELL PURPOSE: Trailer
 (home, irrigation, municipal, industrial)

- WELL COMPLETION DATA:
- (1) diameter (inches) 4"
 - (2) total depth (feet) 107
 - (3) static water level (feet) 20 below top of ground.
 - (4) casing Plastic bottom
 (material) (depth)
 - (size) If telescope see back.
 - (5) screen 6' 10'
 (length) (depth to top)
 - 4" plastic
 (size) (material)
 - (6) pump hercules
 (HP) (yield gpm)
 - elect
 (type power)
 - (7) electric log no
 (yes or no)
 - (organization running log)

(8) how well bottom plugged
water plug

DRILLERS REMARKS:
no remark

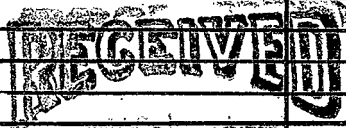


AUG 18 1976

MISS. B. OF WATER COMMISSIONERS

If well telescopes please sketch and show depths.

GROUND LEVEL

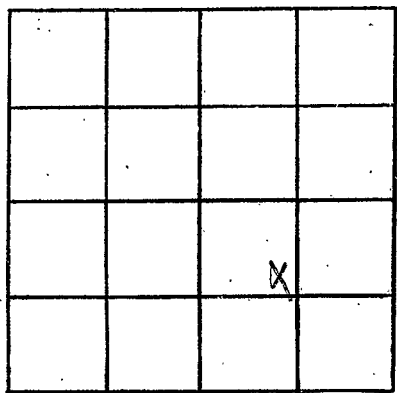

SECTION 26

Please indicate well location X.

ADDITIONAL INFORMATION

A series of horizontal lines for writing additional information, starting below the 'ADDITIONAL INFORMATION' header and extending to the bottom of the page.

If more than one screen, show locations of each on sketch.