

Pike  
 L 2002  
 5-10-76

MISSISSIPPI  
 BOARD OF WATER COMMISSIONERS  
 416 North State Street  
 Jackson, Mississippi 39201

WATER WELL DRILLERS LOG


5-10 date well completed 1976 26 *Fitzgerald Well Serv* firm name *Pike* county well located

LANDOWNER:	description of formations encountered	from	to
<i>Coral Fair</i>			
<i>RR Osyer</i> (mailing address)	<i>Red Clay</i> <i>Red Sand</i> <i>Coarse Sand &amp; Gravel</i>	0 20 120	20 120 136
WELL LOCATION:			
sec. <u>33</u> T <u>10</u> N R <u>8</u> E S W			
<u>6</u> miles <u>E</u> of <u>Osyer</u> (distance) (direction) (nearest town)			
WELL PURPOSE: <u>Home</u> (home, irrigation, municipal, industrial)			
WELL COMPLETION DATA:			
(1) diameter (inches) <u>4</u>			
(2) total depth (feet) <u>136</u>			
(3) static water level (feet) <u>90</u> below top of ground.			
(4) casing <u>PVC</u> , <u>128</u> , (material) (depth)			
<u>4</u> If telescope see back. (size)			
(5) screen <u>8</u> , <u>128</u> (length) (depth to top)			
<u>4</u> , <u>PVC</u> (size) (material)			
(6) pump <u>1/2</u> , <u>10</u> (HP) (yield gpm)			
<u>elm</u> (type power)			
(7) electric log <u>Yes</u> (yes or no)			
(organization running log)			
(8) how well bottom plugged <u>Small</u>			
DRILLERS REMARKS:			

MISSISSIPPI  
 BOARD OF WATER COMMISSIONERS  
 JUL 1 1976  
 MISS. Bd. OF WATER COMMISSIONERS

If well telescopes please sketch and show depths.

GROUND LEVEL

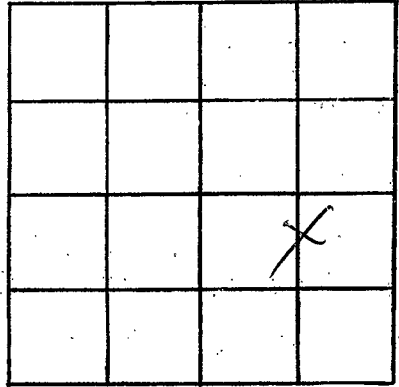

SECTION 33

Please indicate well location X.

ADDITIONAL INFORMATION

If more than one screen, show locations of each on sketch.