

Pike
 L 2003
 5/11/76

MISSISSIPPI
 BOARD OF WATER COMMISSIONERS
 416 North State Street
 Jackson, Mississippi 39201

WATER WELL DRILLERS LOG

May 11 1976 ^{14H} *Reverend Service* *Pike*
 date well completed firm name county well located

LANDOWNER:
Curtis Mack
Rt. asheya
 (mailing address)

description of formations encountered	from	to
<i>Clay</i>	<i>0</i>	<i>20</i>
<i>lumpy sand</i>	<i>20</i>	<i>60</i>
<i>sandy gravel</i>	<i>60</i>	<i>90</i>
<i>pink chalk</i>	<i>90</i>	<i>105</i>
<i>sand & gravel</i>	<i>105</i>	<i>121</i>

WELL LOCATION:
 sec. 2 T. 1 N R. 8 E
2 1/2 miles W. NW of Progress
 (distance) (direction) (nearest town)

WELL PURPOSE: Home
 (home, irrigation, municipal, industrial)

- WELL COMPLETION DATA:
- (1) diameter (inches) 4"
 - (2) total depth (feet) 121
 - (3) static water level (feet) 80 below top of ground.
 - (4) casing plastic bottom
 (material) (depth)
 - (5) screen 6' 115'
 (length) (depth to top)
 - 4" plastic
 (size) (material)
 - (6) pump 1/2 sub 10
 (HP) (yield gpm)
 - elect
 (type power)
 - (7) electric log no
 (yes or no)
 - (organization running log)

(8) how well bottom plugged
wooden plug


DRILLERS REMARKS:
old slow

RECEIVED
 AUG 16 1976

MISS. BD. OF WATER COMM

If well telescopes please sketch and show depths.

GROUND LEVEL

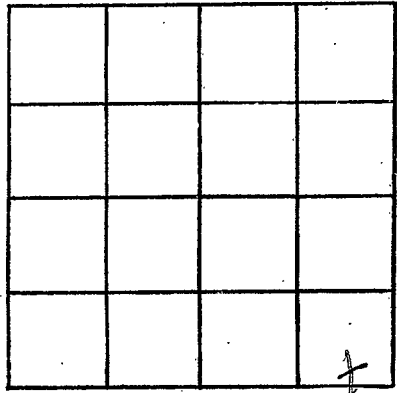

SECTION 2

Please indicate well location X.

ADDITIONAL INFORMATION

If more than one screen, show locations of each on sketch.