

Pipe  
 L 2004  
 5/12/76

MISSISSIPPI  
 BOARD OF WATER COMMISSIONERS  
 416 North State Street  
 Jackson, Mississippi 39201

WATER WELL DRILLERS LOG

May 12 1976 Progres Well Ser Pipe  
 date well completed firm name county well located

LANDOWNER:  
Bill Lassiter  
Rt. 2500  
 (mailing address)

description of formations encountered	from	to
clay	0	8
red sand	8	40
tabble	40	60
small pebbles & sand	60	83

WELL LOCATION:  
 sec. 26 T 1 N R 8 E  
3 miles W.S.W. of Progres  
 (distance) (direction) (nearest town)

WELL PURPOSE: home  
 (home, irrigation, municipal, industrial)

- WELL COMPLETION DATA:
- (1) diameter (inches) 4"
  - (2) total depth (feet) 83
  - (3) static water level (feet) 39 below top of ground.
  - (4) casing plastic bottom  
 (material) (depth)
  - If telescope see back.  
 (size)
  - (5) screen 6" 77  
 (length) (depth to top)
  - 4" plastic  
 (size) (material)
  - (6) pump 1/2 hp             
 (HP) (yield gpm)
  - elect  
 (type power)
  - (7) electric log no  
 (yes or no)
  - (organization running log)

(8) how well bottom plugged  
wooden plug


DRILLERS REMARKS:  
no remark

RECEIVED  
 AUG 16 1976

MISS. BD. OF WATER COMMISSIONERS

If well telescopes please sketch and show depths.

GROUND LEVEL

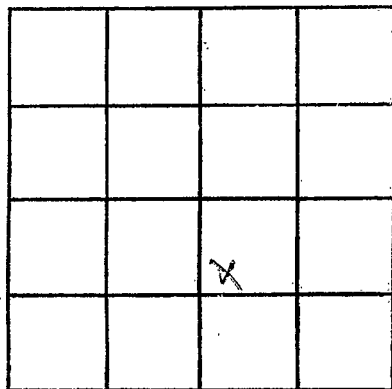

SECTION *26*

Please indicate well location X.

ADDITIONAL INFORMATION

If more than one screen, show locations of each on sketch.