

Pike
 L 2009
 2/21/77

MISSISSIPPI
 BOARD OF WATER COMMISSIONERS
 416 North State Street
 Jackson, Mississippi 39201

116

WATER WELL DRILLERS LOG

Feb 21 1977 Remondell Inc Pike
 date well completed firm name county well located

LANDOWNER:
Milton Kertinberg
Pt 4, Magnolia
 (mailing address)

description of formations encountered	from	to
Red clay	0	11
Chalky sand	11	70
sand & gravel	70	80
shales	80	100
sand & gravel	100	112

WELL LOCATION:
 sec. 12 T 1 N R 8 E
2 miles N-W of Progre
 (distance) (direction) (nearest town)

WELL PURPOSE: Home
 (home, irrigation, municipal, industrial)

WELL COMPLETION DATA:
 (1) diameter (inches) 4
 (2) total depth (feet) 112
 (3) static water level (feet) 70 below top of ground.
 (4) casing plastic, bottom (material) (depth)
 (size) if telescope see back.
 (5) screen 5' (length) 10' (depth to top)
1/2" (size) plastic (material)
 (6) pump 1/2 (HP) 10 (yield gpm)
elect (type power)
 (7) electric log No (yes or no)
 (organization running log)

(8) how well bottom plugged
wooden plug


DRILLERS REMARKS:

RECEIVED
 MAR 21 1977

MISS. BF. OF WATER COMMISSIONERS

If well telescopes please sketch and show depths.

GROUND LEVEL

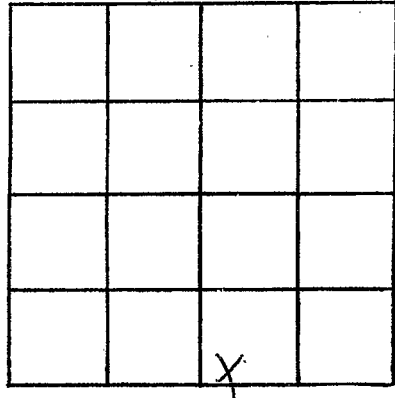

SECTION 12

Please indicate well location X.

ADDITIONAL INFORMATION

If more than one screen, show locations of each on sketch.