

Pike
 L 2012
 10/31/77

MISSISSIPPI
 BOARD OF WATER COMMISSIONERS
 416 North State Street
 Jackson, Mississippi 39201

WATER WELL DRILLERS LOG

10-31 1977 F. General Well Service Pike
 date well completed firm name county well located


LANDOWNER:	description of formations encountered	from	to
<u>Willie W. Bunnifield</u> <u>R.R. Oyster</u> (mailing address)			
WELL LOCATION: sec. <u>34</u> T. <u>1</u> N. R. <u>8</u> E. <u>8</u> miles <u>E</u> of <u>Oyster</u> (distance) (direction) (nearest town)			
WELL PURPOSE: (home, irrigation, municipal, industrial)			
WELL COMPLETION DATA:			
(1) diameter (inches) <u>4</u>			
(2) total depth (feet) <u>138</u>			
(3) static water level (feet) <u>100</u> below above top of ground.			
(4) casing <u>PVC</u> , <u>130</u> , (material) (depth) <u>4</u> if telescope see back. (size)			
(5) screen <u>8</u> , <u>130</u> (length) (depth to top) <u>4</u> , <u>PVC</u> (size) (material)			
(6) pump <u>1/2</u> , <u>10</u> (HP) (yield gpm) <u>Electric</u> (type power)			
(7) electric log <u>no</u> (yes or no) (organization running log)			
(8) how well bottom plugged <u>Small block</u>			
DRILLERS REMARKS:			

RECEIVED
 DEC 28 1977

MISS. BD. OF WATER COMMISSIONERS

If well telescopes please sketch and show depths.

GROUND LEVEL

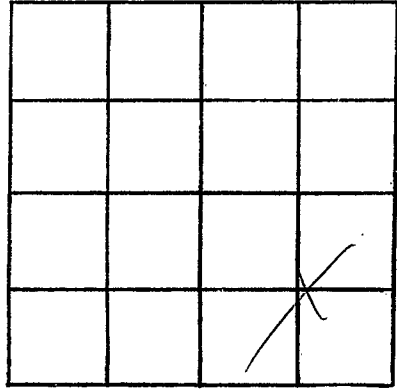

SECTION 34

Please indicate well location X.

ADDITIONAL INFORMATION

If more than one screen,
show locations of each on sketch.