

Pike  
 L 2013  
 12/14/77

MISSISSIPPI  
 BOARD OF WATER COMMISSIONERS  
 416 North State Street  
 Jackson, Mississippi 39201

WATER WELL DRILLERS LOG

12-14 1977 *Fitzwell* *Pike*  
 date well completed firm name county well located


LANDOWNER:	description of formations encountered	from	to
<i>Bill Jackson</i>			
(mailing address)	<i>Red clay</i>	6	20
WELL LOCATION:	<i>Red sand</i>	20	120
sec. <u>6</u> T. <u>10</u> N. R. <u>8</u> E. S. <u>W</u>	<i>Coarse sand &amp; gravel</i>	120	133
4 miles <u>SSE</u> of <u>Wagnolia</u>			
(distance) (direction) (nearest town)			
WELL PURPOSE: <u>Home</u>			
(home, irrigation, municipal, industrial)			
WELL COMPLETION DATA:			
(1) diameter (inches) <u>4</u>			
(2) total depth (feet) <u>133</u>			
(3) static water level (feet) <u>25</u> below above top of ground.			
(4) casing <u>PVC, 125</u>			
(material) (depth)			
<u>4</u> if telescope see back.			
(size)			
(5) screen <u>8</u> , <u>125</u>			
(length) (depth to top)			
<u>4</u> , <u>PVC</u>			
(size) (material)			
(6) pump <u>1/2</u> , <u>10</u>			
(HP) (yield gpm)			
<u>Electric</u>			
(type power)			
(7) electric log <u>no</u>			
(yes or no)			
(organization running log)			
(8) how well bottom plugged <u>Seal plug</u>			
DRILLERS REMARKS:			

RECEIVED  
 DEC 28 1977

MISS. BD. OF WATER COMMISSIONERS

If well telescopes please sketch and show depths.

GROUND LEVEL

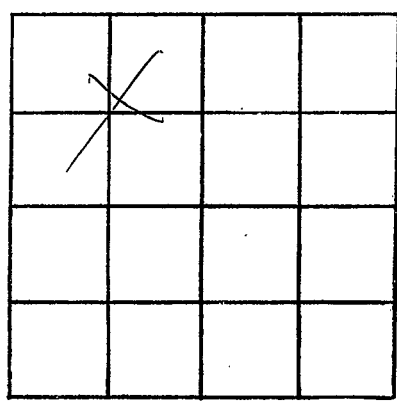

SECTION 6

Please indicate well location X.

ADDITIONAL INFORMATION

A series of horizontal lines for writing additional information.

If more than one screen, show locations of each on sketch.