

PIKE
 2014 L
 1-27-78

MISSISSIPPI
 BOARD OF WATER COMMISSIONERS
 416 North State Street
 Jackson, Mississippi 39201

WATER WELL DRILLERS LOG


Jan 27 1978 *Reams well service Pipe*
 date well completed firm name county well located

LANDOWNER:	description of formations encountered	from	to
<i>Walter Lee</i> <i>Rt. Oseya</i> (mailing address)	<i>Clay</i> <i>Red sand</i> <i>pink Chalk</i> <i>sand & gravel</i>	<i>0</i> <i>8</i> <i>25</i> <i>32</i>	<i>8</i> <i>25</i> <i>32</i> <i>64</i>
WELL LOCATION:			
sec. <i>32</i> T <i>1</i> N R <i>8</i> E			
<i>3</i> miles <i>west</i> of <i>Oseya</i> (distance) (direction) (nearest town)			
WELL PURPOSE: <i>house</i> (home, irrigation, municipal, industrial)			
WELL COMPLETION DATA:			
(1) diameter (inches) <i>4"</i>			
(2) total depth (feet) <i>64</i>			
(3) static water level (feet) <i>35</i> ^{below} _{above} top of ground.			
(4) casing <i>plastic bottom</i> (material) (depth)			
_____ if telescope see back. (size)			
(5) screen <i>5"</i> <i>59</i> (length) (depth to top)			
<i>4"</i> <i>plastic</i> (size) (material)			
(6) pump <i>gas driven</i> (HP) (yield gpm)			
<i>split</i> (type power)			
(7) electric log <i>no</i> (yes or no)			
_____ (organization running log)			
(8) how well bottom plugged <i>wooden plug</i>			
DRILLERS REMARKS: _____			

RECEIVED
 MAY 11 1978

If well telescopes please sketch and show depths.

GROUND LEVEL

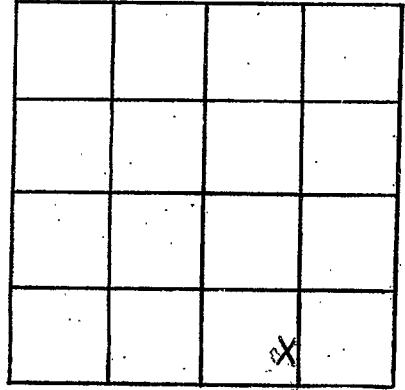

SECTION 32

Please indicate well location X.

ADDITIONAL INFORMATION

If more than one screen,
show locations of each on sketch.