

PIKE
L 2016
8-2-78

**MISSISSIPPI
BOARD OF WATER COMMISSIONERS**
416 North State Street
Jackson, Mississippi 39201

WATER WELL DRILLERS LOG

8-2-78 1978 Fitzgerald Well Serv Pike
date well completed firm name county well located

LANDOWNER:
Johnny Stewart
R.R. Magnolia, ms
(mailing address)

description of formations encountered	from	to
<u>Red clay</u>	<u>0</u>	<u>20</u>
<u>Red Soil</u>	<u>20</u>	<u>80</u>
<u>Coarse sand & gravel</u>	<u>80</u>	<u>108</u>

WELL LOCATION:
sec. 14 T 1 N R 8 E
 S W
10 miles E of Magnolia
(distance) (direction) (nearest town)

WELL PURPOSE: Home
(home, irrigation, municipal, industrial)

WELL COMPLETION DATA:

(1) diameter (inches) 4

(2) total depth (feet) 108

(3) static water level (feet) 70 below above top of ground.

(4) casing PVC 100
(material) (depth)
4 if telescope see back.
(size)

(5) screen 8 100
(length) (depth to top).
4 PVC
(size) (material)

(6) pump 1/2 10
(HP) (yield gpm)
eli
(type power)

(7) electric log no
(yes or no)
(organization running log)


(8) how well bottom plugged ball ball

DRILLERS REMARKS:

RECEIVED
OCT 3 1978
MISS. BD. OF WATER COMMISSIONERS

If well telescopes please sketch and show depths.

GROUND LEVEL

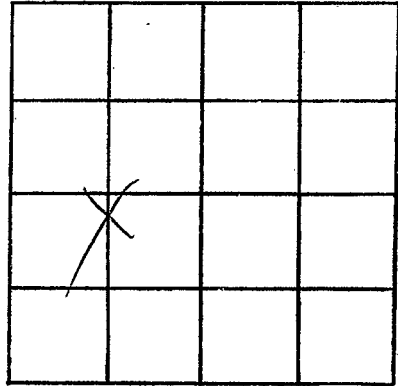

SECTION 14

Please indicate well location X.

ADDITIONAL INFORMATION

If more than one screen,
show locations of each on sketch.