

PIKE
 L 2017
 7-10-78

MISSISSIPPI
 BOARD OF WATER COMMISSIONERS
 416 North State Street
 Jackson, Mississippi 39201

WATER WELL DRILLERS LOG

July 10 1978 Stopped Well Ser. Pike Co.
 date well completed firm name county well located

LANDOWNER: Clyde M. Cook
 (mailing address)

WELL LOCATION:
 sec. 5 T. 1 N. R. 8 E
 8.5 miles N/W of Rogers
 (distance) (direction) (nearest town)

WELL PURPOSE: Home
 (home, irrigation, municipal, industrial)

- WELL COMPLETION DATA:
- (1) diameter (inches) 4"
 - (2) total depth (feet) 80 ft.
 - (3) static water level (feet) 60 below top of ground
 - (4) casing plastic 70 (material) (depth)
 4 (size) if telescope see back.
 - (5) screen 10 ft. 70 (length) (depth to top)
 4" plastic (size) (material)
 - (6) pump 1/2 (HP) 1.2 (yield gpm)
 Elect. (type power)
 - (7) electric log (yes or no)

(organization running log)
 (8) how well bottom plugged B/p/p

DRILLERS REMARKS:
 [Signature]

description of formations encountered	from	to
Top	0	2
red clay	2	35
sand + gravel	35	60
gravel	60	80


RECEIVED

OCT 10 1978

MISS. BD. OF WATER COMMISSIONERS

If well telescopes please sketch and show depths.

GROUND LEVEL

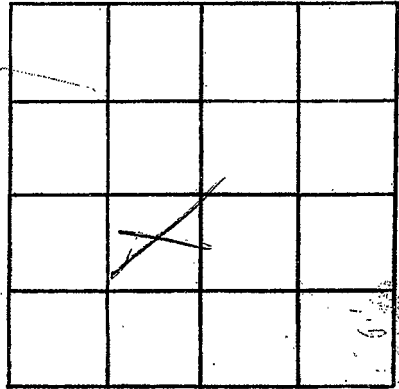

SECTION _____

Please indicate well location X.

ADDITIONAL INFORMATION

If more than one screen, show locations of each on sketch.