

PIKE

L 2012

7-31-78

MISSISSIPPI BOARD OF WATER COMMISSIONERS 416 North State Street Jackson, Mississippi 39201

WATER WELL DRILLERS LOG

July 31 1978 Peewell Pike date well completed firm name county well located

LANDOWNER:

Ed Fortenberry Rt Magnolia (mailing address)

description of formations encountered

Red Clay 0 22 Red sand 22 60 sand + gravel 60 85 shaly sand 85 124 gravelly sand 124 140

from to

WELL LOCATION:

sec. 4 T-1 N R-8 E 5 miles WNW of Progress (distance) (direction) (nearest town)

WELL PURPOSE: garden (home, irrigation, municipal, industrial)

WELL COMPLETION DATA:

- (1) diameter (inches) 4" (2) total depth (feet) 140 (3) static water level (feet) 85 below top of ground. (4) casing plastic (bottom) (material) (depth) (size) if telescope see back. (5) screen 5" (length) 135' (depth to top) 4" (size) plastic (material) (6) pump 1/2 HP (yield gpm) other (7) electric log 200 (yes or no) (organization running log)

(8) how well bottom plugged washed plug


DRILLERS REMARKS:

RECEIVED DEC 29 1978

MISS. BD. OF WATER COMMISSIONERS

If well telescopes please sketch and show depths.

GROUND LEVEL

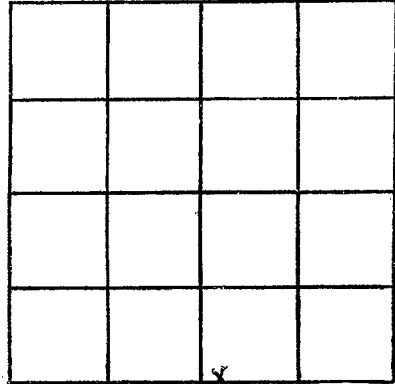

SECTION 4

Please indicate well location X.

ADDITIONAL INFORMATION

If more than one screen, show locations of each on sketch.