

|         |
|---------|
| PIKE    |
| L 209   |
| 8-04-78 |

**MISSISSIPPI  
BOARD OF WATER COMMISSIONERS**  
416 North State Street  
Jackson, Mississippi 39201

**WATER WELL DRILLERS LOG**

Aug. 4 1978 Reynolds Pike  
 date well completed      firm name      county well located

**LANDOWNER:**  
Rusty Pipes  
Pt. Osborne  
 (mailing address)

| description of formations encountered | from       | to         |
|---------------------------------------|------------|------------|
| <u>Red clay</u>                       | <u>0</u>   | <u>18</u>  |
| <u>Red sand</u>                       | <u>18</u>  | <u>76</u>  |
| <u>Sand + gravel</u>                  | <u>76</u>  | <u>82</u>  |
| <u>Coarse sand</u>                    | <u>82</u>  | <u>145</u> |
| <u>lobbly sand</u>                    |            |            |
| <u>coarse sand</u>                    | <u>145</u> | <u>160</u> |

**WELL LOCATION:**  
 sec. 34 T-1 N R-8 E  
5 miles east of Osborne  
 (distance) (direction) (nearest town)

**WELL PURPOSE:** Family  
 (home, irrigation, municipal, industrial)

**WELL COMPLETION DATA:**

(1) diameter (inches) 4"

(2) total depth (feet) 160

(3) static water level (feet) 74 below top of ground.

(4) casing plastic bottom  
 (material) (depth)

       If telescope see back.  
 (size)

(5) screen 5' 155'  
 (length) (depth to top)

4" plastic  
 (size) (material)

(6) pump 1/2 hp 10  
 (HP) (yield gpm)

elect  
 (type power)

(7) electric log no  
 (yes or no)

        
 (organization running log)


(8) how well bottom plugged water plug

**DRILLERS REMARKS:**  
      

**RECEIVED**  
 DEC 29 1978  
 MISS. BD. OF WATER COMMISSIONERS

If well telescopes please sketch and show depths.

GROUND LEVEL

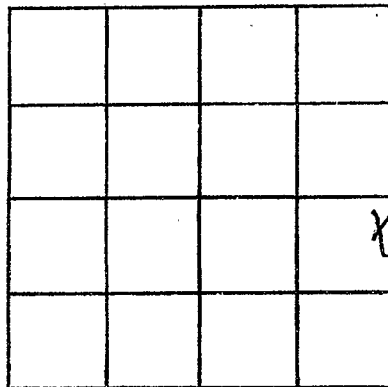

SECTION 34

Please indicate well location X.

ADDITIONAL INFORMATION

If more than one screen,  
show locations of each on sketch.