

PIKE
L 2000
9-19-78

MISSISSIPPI
 BOARD OF WATER COMMISSIONERS
 416 North State Street
 Jackson, Mississippi 39201

WATER WELL DRILLERS LOG

Sept 19 1978 Runnacker Pike
 date well completed firm name county well located

LANDOWNER:
Eddie Simon
Rt Osyka.
 (mailing address)

description of formations encountered	from	to
<u>sandy clay</u>	<u>0</u>	<u>16</u>
<u>pink chalk</u>	<u>16</u>	<u>40</u>
<u>red sandy sand</u>	<u>40</u>	<u>110</u>
<u>red sand</u>	<u>110</u>	<u>128</u>

WELL LOCATION:
 sec 26 T L N R 8 E
5 1/2 miles E-NE of Osyka
 (distance) (direction) (nearest town)

WELL PURPOSE: house
 (home, irrigation, municipal, industrial)

WELL COMPLETION DATA:

(1) diameter (inches) 4"

(2) total depth (feet) 128

(3) static water level (feet) 89 below top of ground.

(4) casing plastic bottom
 (material) (depth)

 if telescope see back.
 (size)

(5) screen 5' 123'
 (length) (depth to top)

4" plastic
 (size) (material)

(6) pump 1/2 10
2 (HP) (yield gpm)

elect
 (type power)

(7) electric log no
 (yes or no)

 (organization running log)


(8) how well bottom plugged
wooden plug

DRILLERS REMARKS:

RECEIVED
 JAN 15 1978
 MISS. BD. OF WATER COMMISSIONERS

If well telescopes please sketch and show depths.

GROUND LEVEL

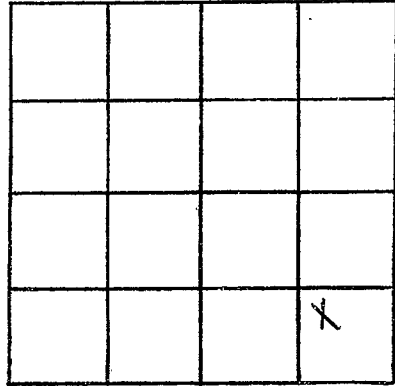

SECTION 26

Please indicate well location X.

ADDITIONAL INFORMATION

If more than one screen,
show locations of each on sketch.