

PIKE  
 L 2021  
 8-06-78

MISSISSIPPI  
 BOARD OF WATER COMMISSIONERS  
 416 North State Street  
 Jackson, Mississippi 39201

WATER WELL DRILLERS LOG

Aug 6 1978 Revera Well Co Pike  
 date well completed firm name county well located


LANDOWNER:	description of formations encountered	from	to
<u>Sedgewick Brook -</u>			
<u>Rt 2 McComb -</u> (mailing address)	<u>Red Clay</u>	<u>0</u>	<u>22</u>
	<u>Red sand</u>	<u>22</u>	<u>70</u>
	<u>Gravel &amp; sand</u>	<u>70</u>	<u>78</u>
	<u>labbly</u>	<u>78</u>	<u>100</u>
	<u>pea gravel &amp; sand</u>	<u>100</u>	<u>112</u>
WELL LOCATION: sec <u>14</u> T <u>1</u> N R <u>8</u> E <u>2 1/2</u> miles <u>west</u> of <u>Progre</u> (distance) (direction) (nearest town)			
WELL PURPOSE: <u>house</u> (home, irrigation, municipal, industrial)			
WELL COMPLETION DATA: (1) diameter (inches) <u>4"</u> (2) total depth (feet) <u>112</u> (3) static water level (feet) <u>78</u> below top of ground. (4) casing <u>plastic bottom</u> (material) (depth) _____ if telescope see back. (size) (5) screen <u>5'</u> <u>107'</u> (length) (depth to top) <u>4"</u> <u>plastic</u> (size) (material) (6) pump <u>1/2 hp</u> <u>10</u> (HP) (yield gpm) <u>elect.</u> (type power) (7) electric log <u>no</u> (yes or no) _____ (organization running log) (8) how well bottom plugged <u>wood plug</u>			
DRILLERS REMARKS:			

RECEIVED  
 DEC 29 1978

MISS. BD. OF WATER COMMISSIONERS

If well telescopes please sketch and show depths.

GROUND LEVEL

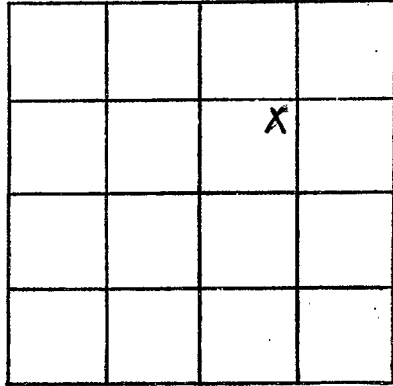

SECTION 14

Please indicate well location X.

ADDITIONAL INFORMATION

If more than one screen, show locations of each on sketch.