

PIKE
L <u>2022</u>
10-6-78

**MISSISSIPPI
BOARD OF WATER COMMISSIONERS**
416 North State Street
Jackson, Mississippi 39201

WATER WELL DRILLERS LOG

10-6 19 78 Fitzgerald Well Sew Pike
 date well completed firm name county well located

LANDOWNER:
Collins Williams
R.B. Ompka, ms -
 (mailing address)

description of formations encountered	from	to
<u>Red clay</u>	<u>0</u>	<u>20</u>
<u>Red sand</u>	<u>20</u>	<u>85</u>
<u>Coarse sand & gravel</u>	<u>85</u>	<u>115</u>

WELL LOCATION:
 sec. 9 T 1 N R. 8 E
 S W
2 miles S of Ballins
 (distance) (direction) (nearest town)

WELL PURPOSE:
 (home, irrigation, municipal, industrial)

WELL COMPLETION DATA:

(1) diameter (inches) 4"

(2) total depth (feet) 115

(3) static water level (feet) 80 below above top of ground.

(4) casing PVC, 107,
 (material) (depth)
4 if telescope see back.
 (size)

(5) screen 8, 107
 (length) (depth to top)
4, PVC
 (size) (material)

(6) pump 1/2, 10
 (HP) (yield gpm)
elec
 (type power)

(7) electric log No
 (yes or no)
 (organization running log)


(8) how well bottom plugged hard shell

DRILLERS REMARKS:

RECEIVED
DEC - 7 1978

If well telescopes please sketch and show depths.

GROUND LEVEL

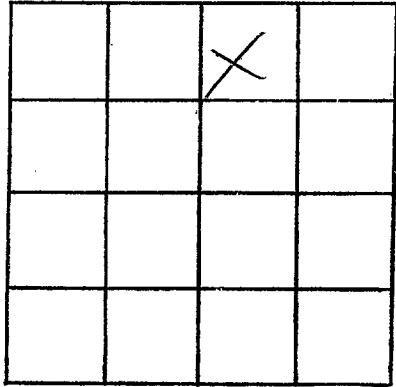

SECTION 9

Please indicate well location X.

ADDITIONAL INFORMATION

Lined area for additional information.

If more than one screen, show locations of each on sketch.