

PIKE
 L 2023
 10-11-78

MISSISSIPPI
 BOARD OF WATER COMMISSIONERS
 416 North State Street
 Jackson, Mississippi 39201

WATER WELL DRILLERS LOG

Oct 11 1978 Beaus Well Ser Pike
 date well completed firm name county well located

LANDOWNER:
Ted Fastenberg
Rt. Magnolia
 (mailing address)

description of formations encountered	from	to
<u>Red Clay</u>	<u>0</u>	<u>22</u>
<u>Red Sand</u>	<u>22</u>	<u>80</u>
<u>Cobbly Sand</u>	<u>80</u>	<u>110</u>
<u>Coarse sand</u>	<u>110</u>	<u>125</u>
<u>Flagstone & sand</u>	<u>125</u>	<u>145</u>

WELL LOCATION:
 sec. 4 T 1 N R 8 E
7 miles S-SE of Magnolia
 (distance) (direction) (nearest town)

WELL PURPOSE: Stone
 (home, irrigation, municipal, industrial)

- WELL COMPLETION DATA:
- (1) diameter (inches) 4"
 - (2) total depth (feet) 145'
 - (3) static water level (feet) 85' below above top of ground.
 - (4) casing plastic bottom
 (material) (depth)
 - (size) if telescope see back.
 - (5) screen 15', 130'
 (length) (depth to top)
 - 4" plastic
 (size) (material)
 - (6) pump weather
 (HP) (yield gpm)
 - elect
 (type power)
 - (7) electric log no
 (yes or no)
 - (organization running log)

(8) how well bottom plugged
wooden plug

DRILLERS REMARKS:


Miss. Board of Water Comm.

FEB 15 1979

RECEIVED

If well telescopes please sketch and show depths.

GROUND LEVEL

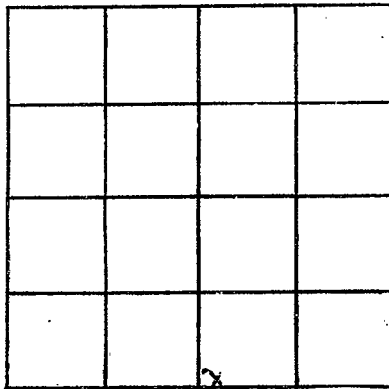

SECTION 4

Please indicate well location X.

ADDITIONAL INFORMATION

If more than one screen, show locations of each on sketch.