

BOARD OF WATER COMMISSIONERS

416 North State Street

Jackson, Mississippi 39201

WATER WELL DRILLERS LOG

PIKE

L 2014

2/20/79

Feb-20

1979 Beems Well Inc

Pike

date well completed

firm name

county well located

LANDOWNER:

Tommy Wilson

At Magnolia (mailing address)

description of formations encountered

from

to

Red Red Clay 0 17
Sand & gravel 17 76
Gravel & sand 76 90

WELL LOCATION:

sec. 11 T 1 N R 8 E

3 miles W. NW of Progress (distance) (direction) (nearest town)

WELL PURPOSE:

Home (home, irrigation, municipal, industrial)

WELL COMPLETION DATA:

- (1) diameter (inches) 4"
(2) total depth (feet) 90'
(3) static water level (feet) 68' below top of ground.
(4) casing plastic bottom (material) (depth)

If telescope see back. (size)

- (5) screen 5' 85' (length) (depth to top)

4" plastic (size) (material)

- (6) pump 1/2 HP 10 (HP) (yield gpm)

1/2 (type power)

- (7) electric log no (yes or no)

(organization running log)

- (8) how well bottom plugged

DRILLERS REMARKS:


Miss. Board of Water Comm.

JUN 18 1979

RECEIVED

If well telescopes please sketch and show depths.

GROUND LEVEL

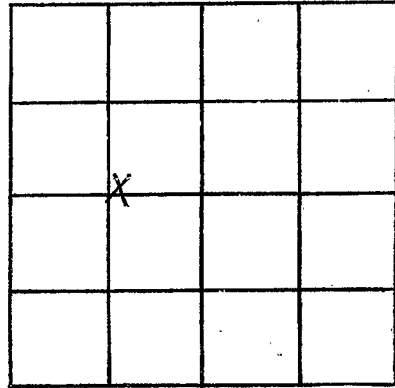

SECTION 11

Please indicate well location X.

ADDITIONAL INFORMATION

If more than one screen,
show locations of each on sketch.