

PIKE
L. <i>Doose</i>
3/12/79

MISSISSIPPI
BOARD OF WATER COMMISSIONERS
416 North State Street
Jackson, Mississippi 39201

WATER WELL DRILLERS LOG

April 12, 1979 *Reems Well Co* Pipe
 date well completed firm name county well located

LANDOWNER:
Gerry P. Johnston
Rt Magnolia
(mailing address)

description of formations encountered	from	to
<i>red clay</i>	<i>0</i>	<i>2 1/2</i>
<i>red sand</i>	<i>2 1/2</i>	<i>3 1/2</i>
<i>sand & gravel</i>	<i>3 1/2</i>	<i>10 1/2</i>

WELL LOCATION:
 sec. *11* T. *1* N. R. *8* E
8 miles *S-SE* of *Magnolia*
 (distance) (direction) (nearest town)

WELL PURPOSE: *home*
 (home, irrigation, municipal, industrial)

WELL COMPLETION DATA:

(1) diameter (inches) *4"*

(2) total depth (feet) *10 1/2*

(3) static water level (feet) *7 1/2* below top of ground

(4) casing *plastic bottom*
 (material) (depth)

0 if telescope see back.
 (size)

(5) screen *5'* *9 1/2'*
 (length) (depth to top)

4' *plastic*
 (size) (material)

(6) pump *1/2* *10*
 (HP) (yield gpm)

elect
 (type power)

(7) electric log *no*
 (yes or no)

(organization running log)

(8) how well bottom plugged
wooden plug

DRILLERS REMARKS:


Miss. Board of Water Comm.

AUG 24 1979

RECEIVED

If well telescopes please sketch and show depths.

GROUND LEVEL

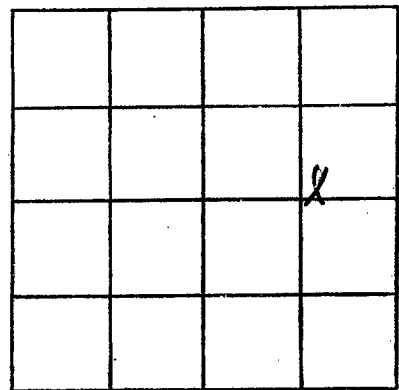

SECTION 11

Please indicate well location X.

ADDITIONAL INFORMATION

A series of horizontal lines for writing additional information, starting below the 'ADDITIONAL INFORMATION' header and extending to the bottom of the page.

If more than one screen, show locations of each on sketch.