

Pike
 2029
 11-2-79

MISSISSIPPI
 BOARD OF WATER COMMISSIONERS
 416 North State Street
 Jackson, Mississippi 39201

WATER WELL DRILLERS LOG

11-2-79 date well completed 19 79 Fitzgerald Well Co firm name Pike county well located

LANDOWNER:
 Willie B. Mason
 R.R. Magnolia
 (mailing address)

description of formations encountered	from	to
Red clay	0	20
Red sand	20	60
Red clay & gravel	60	110
Caene sand & gravel	110	120

WELL LOCATION:
 sec. 4 T 1 N R 8 E
 S W
 7 miles E of MOBILE
 (distance) (direction) (nearest town)

WELL PURPOSE: Home
 (home, irrigation, municipal, industrial)

- WELL COMPLETION DATA:
- (1) diameter (inches) 4
 - (2) total depth (feet) 120
 - (3) static water level (feet) 50 below above top of ground.
 - (4) casing PVC 112
 (material) (depth)
 4 if telescope see back.
 (size)
 - (5) screen 8 112
 (length) (depth to top)
 4 PVC
 (size) (material)
 - (6) pump 1/2 10
 (HP) (yield gpm)
 ch
 (type power)
 - (7) electric log yes or no
 - (organization running log)
 - (8) how well bottom plugged Paul H. H.

DEPT. OF NATURAL RESOURCES
 BUREAU OF LAND & WATER RESOURCES


NOV - 7 1979

DRILLERS REMARKS:

RECEIVED

If well telescopes please sketch and show depths.

GROUND LEVEL

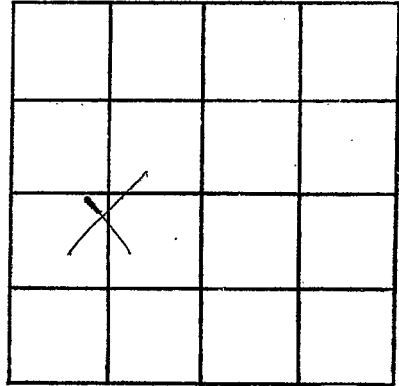

SECTION 2/

Please indicate well location X.

ADDITIONAL INFORMATION

If more than one screen, show locations of each on sketch.