

Pike
 L 2030
 11-27-79

MISSISSIPPI
 BOARD OF WATER COMMISSIONERS
 416 North State Street
 Jackson, Mississippi 39201

WATER WELL DRILLERS LOG

11-27-1979 date well completed
 Fitzgerald well firm name
 Pike county well located

LANDOWNER:
 Early Ray chess
 R.R. (Mailing address)

description of formations encountered	from	to
Red clay	0	20
Red sand	20	90
Red gravel	90	115
Coarse sand & gravel	115	132

WELL LOCATION:
 sec. 10 T. 1 N. R. 8 E
 1 miles E of Ball
 (distance) (direction) (nearest town)

WELL PURPOSE: Home
 (home, irrigation, municipal, industrial)

- WELL COMPLETION DATA:
- (1) diameter (inches) 4
 - (2) total depth (feet) 132
 - (3) static water level (feet) 60 below top of ground.
 - (4) casing PVC, 124 (depth)
 4 (size) if telescope see back.
 - (5) screen 8 (length), 124 (depth to top)
 4 (size), PVC (material)
 - (6) pump 1/2 (HP), 10 (yield gpm)
 elec (type power)
 - (7) electric log No (yes or no)
 (organization running log)
 - (8) how well bottom plugged Sand shell

DEPT. OF NATURAL RESOURCES
 BUREAU OF LAND & WATER RESOURCES


JAN 31 1980

RECEIVED

DRILLERS REMARKS:

If well telescopes please sketch and show depths.

GROUND LEVEL

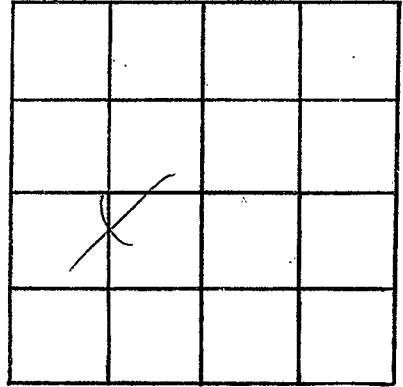

SECTION 10

Please indicate well location X.

ADDITIONAL INFORMATION

If more than one screen,
show locations of each on sketch.