

Pike
L 2031
1-6-80

MISSISSIPPI
 BOARD OF WATER COMMISSIONERS
 416 North State Street
 Jackson, Mississippi 39201


WATER WELL DRILLERS LOG

1-6 19 80 F. H. G. Well Serv Pike
 date well completed firm name county well located

LANDOWNER:	description of formations encountered	from	to
<u>Webster Chew</u>	<u>Red Clay</u>	<u>0</u>	<u>20</u>
<u>P.O. [unclear] [unclear]</u> (mailing address)	<u>Red sand</u>	<u>20</u>	<u>120</u>
WELL LOCATION: sec. <u>10</u> T. <u>1</u> (N) S R. <u>8</u> (E) W <u>1 1/2</u> miles <u>E</u> of <u>Belle</u> (distance) (direction) (nearest town)	<u>Coarse sand & gravel</u>	<u>120</u>	<u>138</u>
WELL PURPOSE: (home, irrigation, municipal, industrial)			
WELL COMPLETION DATA: (1) diameter (inches) <u>4</u> (2) total depth (feet) <u>138</u> (3) static water level (feet) <u>55</u> below above top of ground. (4) casing <u>4</u> (material), <u>130</u> (depth), <u>4</u> (size) if telescope see back. (5) screen <u>8</u> (length), <u>130</u> (depth to top), <u>4</u> (size), <u>100</u> (material) (6) pump <u>3/4</u> (HP), <u>15</u> (yield gpm), <u>4</u> (type power) (7) electric log <u>no</u> (yes or no) <u>[unclear]</u> (organization running log) (8) how well bottom plugged <u>Level Shallow</u>			
DRILLERS REMARKS:	<p>DEPT. OF NATURAL RESOURCES BUREAU OF LAND & WATER RESOURCES</p> <p>JAN 31 1980</p> <p>RECEIVED</p>		

If well telescopes please sketch and show depths.

GROUND LEVEL

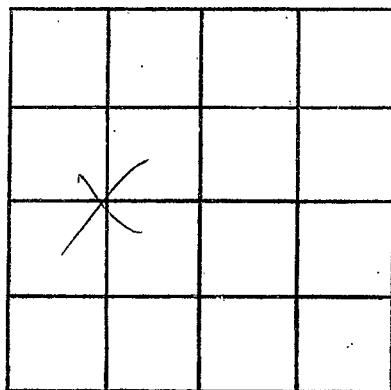

SECTION 10

Please indicate well location X.

ADDITIONAL INFORMATION

If more than one screen,
show locations of each on sketch.