

MISSISSIPPI DEPARTMENT OF NATURAL RESOURCES

Bureau of Land and Water Resources

Southport Mall

P.O. Box 10631

Jackson, Mississippi 39209

WATER WELL DRILLERS LOG

Pike
L 2032
2-5-80

Feb-5 1980 Reynolds Well Co. Pike
 date well completed firm name county well located

LANDOWNER:
L. P. Ryker
Rt. 2, Osyka
 (mailing address)

WELL LOCATION:
 section 34 T 1 N R 8 E
5 miles east of Osyka
 (distance) (direction) (nearest town)

WELL PURPOSE: home
 (home, irrigation, municipal, industrial)

description of formations encountered	from	to
<u>Red clay</u>	<u>0</u>	<u>16</u>
<u>Red sand</u>	<u>16</u>	<u>59</u>
<u>Sand + gravel</u>	<u>58</u>	<u>70</u>
<u>pink chalk</u>	<u>70</u>	<u>85</u>
<u>blue sand</u>	<u>85</u>	<u>90</u>
<u>Chalk + gravel</u>	<u>90</u>	<u>102</u>
<u>Sand + small gravel</u>	<u>100</u>	<u>111</u>

WELL COMPLETION DATA:

(1) diameter (inches) 4"

(2) total depth (feet) 111'

(3) static water level (feet) 60' ^{below} ~~above~~ top of ground.

(4) casing plastic bottom
 (material) (depth)

5' If telescope see back.
 (size)

(5) screen 5' 106'
 (length) (depth to top)

4" plastic
 (size) (material)

(6) pump 3/4 12
 (HP) (yield gpm)

split
 (type power)

(7) electric log no
 (yes or no)

-
 (organization running log)

(8) how well bottom plugged backwash valve

DRILLERS REMARKS:


DEPT. OF NATURAL RESOURCES
 BUREAU OF LAND & WATER RESOURCES

NOV 14 1980

RECEIVED

If well telescopes please sketch and show depths.

GROUND LEVEL

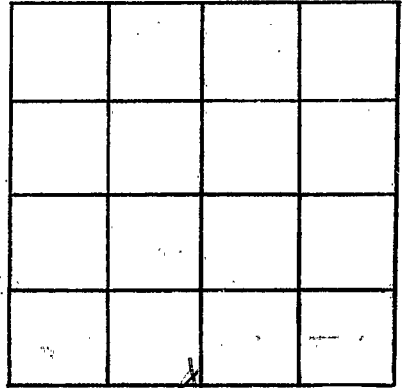

SECTION 34

Please indicate well location X.

ADDITIONAL INFORMATION

If more than one screen, show locations of each on sketch.