

Duke
L 2033
4-30-80

MISSISSIPPI
 BOARD OF WATER COMMISSIONERS
 416 North State Street
 Jackson, Mississippi 39201

WATER WELL DRILLERS LOG

April 30 1980 Pleues Wellers Pike
 date well completed firm name county well located

LANDOWNER:
Felix Dunn
Pt. Magnolia
 (mailing address)

WELL LOCATION:
 sec. 9 T. 1 N. R. 8 E
7 1/2 miles ESE of Magnolia
 (distance) (direction) (nearest town)

WELL PURPOSE: house
 (home, irrigation, municipal, industrial)

WELL COMPLETION DATA:
 (1) diameter (inches) 4"
 (2) total depth (feet) 132
 (3) static water level (feet) 68' below top of ground.
 (4) casing plastic bottom
 (material) (depth)
 If telescope see back.
 (size)
 (5) screen 5', 127'
 (length) (depth to top)
4", plastic
 (size) (material)
 (6) pump 1/2 Sub 10
 (HP) (yield gpm)
elect
 (type power)
 (7) electric log no
 (yes or no)
 (organization running log)

description of formations encountered	from	to
<u>Clay</u>	<u>0</u>	<u>27</u>
<u>Red sand</u>	<u>27</u>	<u>60</u>
<u>Red Chalk</u>	<u>60</u>	<u>85</u>
<u>Chalk, sand & gravel</u>	<u>85</u>	<u>115</u>
<u>sand & gravel</u>	<u>115</u>	<u>132</u>

DEPT. OF NATURAL RESOURCES
 BUREAU OF LAND & WATER RESOURCES


JAN 12 1981

RECEIVED

(8) how well bottom plugged: lock wash valve
 DRILLERS REMARKS:

If well telescopes please sketch and show depths.

GROUND LEVEL

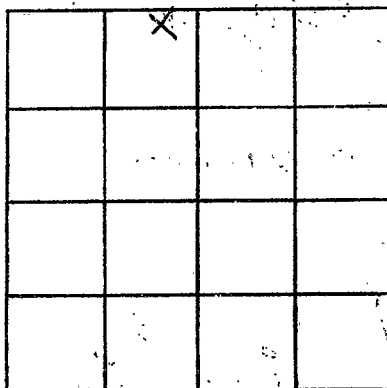

SECTION _____

Please indicate well location X.

ADDITIONAL INFORMATION

If more than one screen, show locations of each on sketch.