

PIKE  
 L 2034  
 5-1-80

MISSISSIPPI  
 BOARD OF WATER COMMISSIONERS  
 416 North State Street  
 Jackson, Mississippi 39201

WATER WELL DRILLERS LOG

May 1 1980 Remus Hill Lu Pike  
 date well completed firm name county well located

LANDOWNER:  
Garry Alford  
Rt. Magnolia  
 (mailing address)

description of formations encountered	from	to
<u>Clay sand &amp; gravel subid</u>	<u>0</u>	<u>7</u>
	<u>7</u>	<u>70</u>
	<u>70</u>	<u>75</u>

WELL LOCATION:  
 sec. 11 T. 1 N. R. 8 E  
2 1/2 miles W. NW of Progress  
 (distance) (direction) (nearest town)

WELL PURPOSE: home  
 (home, irrigation, municipal, industrial)

WELL COMPLETION DATA:  
 (1) diameter (inches) 4"  
 (2) total depth (feet) 73  
 (3) static water level (feet) 50' below top of ground.  
 (4) casing plastic, bottom  
 (material) (depth)  
 (size) if telescope see back.  
 (5) screen 5' , 18'  
 (length) (depth to top)  
4" , plastic  
 (size) (material)  
 (6) pump 1/2 atkins  
 (HP) (yield gpm)  
chest  
 (type power)  
 (7) electric log no  
 (yes or no)  
 (organization running log)


DEPT. OF NATURAL RESOURCES  
 BUREAU OF LAND & WATER RESOURCES  
 JAN 12 1981

(8) how well bottom plugged  
coarse mesh valve  
 DRILLERS REMARKS:  
 \_\_\_\_\_

RECEIVED

If well telescopes please sketch and show depths.

GROUND LEVEL

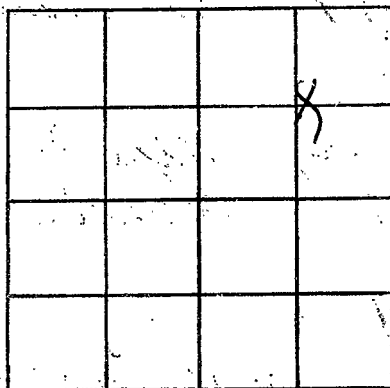

SECTION 17

Please indicate well location X.

ADDITIONAL INFORMATION

If more than one screen, show locations of each on sketch.