


Pike
L 2035
7-9-80

MISSISSIPPI
 BOARD OF WATER COMMISSIONERS FEB 13 1981
 416 North State Street
 Jackson, Mississippi 39201

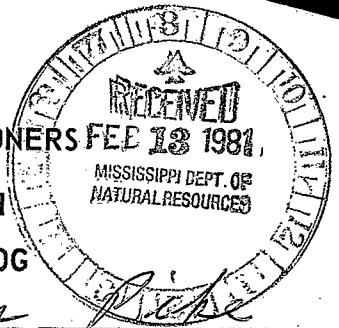

WATER WELL DRILLERS LOG

date well completed July 9 1980 firm name Reuss Well Co county well located Pike

LANDOWNER:
Lizzie Hipping
At. Macdonald
 (mailing address)

description of formations encountered	from	to
<u>Red sandy clay</u>	<u>0</u>	<u>26</u>
<u>Red sand</u>	<u>26</u>	<u>70</u>
<u>hard gravel</u>	<u>70</u>	<u>85</u>
<u>sandy gravel</u>	<u>85</u>	<u>105</u>
<u>small gravel + sand</u>	<u>105</u>	<u>119</u>

WELL LOCATION:
 sec 9 T 1 N R 8 E
5 miles West of Progress
 (distance) (direction) (nearest town)

WELL PURPOSE: home
 (home, irrigation, municipal, industrial)

- WELL COMPLETION DATA:
- diameter (inches) 4"
 - total depth (feet) 119'
 - static water level (feet) 76' below top of ground
 - casing plastic, bottom
 (material) (depth)
2 if telescope see back.
 (size)
 - screen 5" 114'
 (length) (depth to top)
4" plastic
 (size) (material)
 - pump 1/2 10
 (HP) (yield gpm)
1/2
 (type power)
 - electric log no
 (yes or no)
 (organization running log)


(8) how well bottom plugged
bedrock water

DRILLERS REMARKS:
✓

DEPT. OF NATURAL RESOURCES
 BUREAU OF LAND & WATER RESOURCES
 FEB 13 1981
 RECEIVED

If well telescopes please sketch and show depths.

GROUND LEVEL

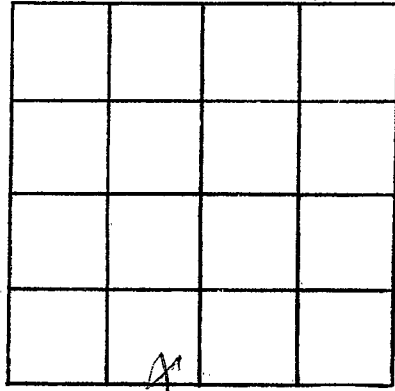

SECTION 9

Please indicate well location X.

ADDITIONAL INFORMATION

A series of horizontal lines for writing additional information, starting below the 'ADDITIONAL INFORMATION' header and extending to the bottom of the page.

If more than one screen, show locations of each on sketch.