

Pike
 L 2030
 6-2-81

MISSISSIPPI
 BOARD OF WATER COMMISSIONERS
 416 North State Street
 Jackson, Mississippi 39201

WATER WELL DRILLERS LOG

6-2 date well completed 1981 firm name Hydromed Well Serv county well located Pike

LANDOWNER:	description of formations encountered	from	to
<u>Richard Montet</u>			
<u>P.R. Mervolia</u> (mailing address)	<u>Real clay</u> <u>Real sand</u> <u>Coarse sand/gravel</u>	<u>6</u>	<u>20</u>
		<u>20</u>	<u>80</u>
		<u>80</u>	<u>102</u>

LANDOWNER:

description of formations encountered

from

to

Richard Montet

P.R. Mervolia
(mailing address)

Real clay
Real sand
Coarse sand/gravel

6

20

20

80

80

102

WELL LOCATION:


sec. 24 T 1 N R 8 E
 S W
2 miles W of Pregron
 (distance) (direction) (nearest town)

WELL PURPOSE:

Home
 (home, irrigation, municipal, industrial)

WELL COMPLETION DATA:


- (1) diameter (inches) 4
- (2) total depth (feet) 102
- (3) static water level (feet) 85 below top of ground.
- (4) casing PVC, 94,
 (material) (depth)
4 if telescope see back.
 (size)
- (5) screen 8, 94
 (length) (depth to top)
4, PVC
 (size) (material)
- (6) pump 1, 20
 (HP) (yield gpm)
Electric
 (type power)
- (7) electric log Yes
 (yes or no)
 (organization running log)
- (8) how well bottom plugged Seal Shok

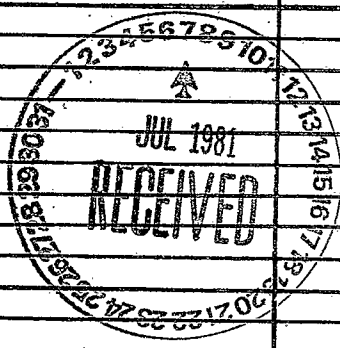

DRILLERS REMARKS:

If well telescopes please sketch and show depths.

GROUND LEVEL

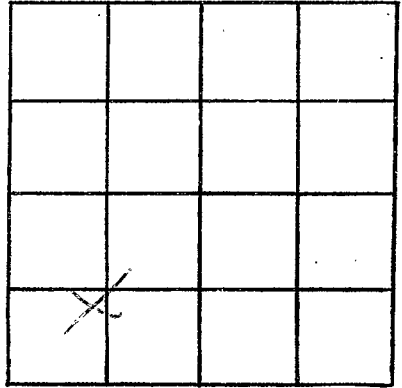

SECTION 24

Please indicate well location X.

ADDITIONAL INFORMATION

If more than one screen,
show locations of each on sketch.