

Pike  
 L2057  
 6-24-81

MISSISSIPPI  
 BOARD OF WATER COMMISSIONERS  
 416 North State Street  
 Jackson, Mississippi 39201


WATER WELL DRILLERS LOG

6-24  
 date well completed

19 81 Fitzgerald Well Serv  
 firm name


Pike  
 county well located

LANDOWNER:	description of formations encountered	from	to
Terline Howard			
RR Magnolia, Ms. (mailing address)	Red clay Red sand Loose sand & gravel	0 20 85	20 85 100
WELL LOCATION:			
sec. 11 T 1 N R 8 E S W			
1 miles SW of Ellen Bro. (distance) (direction) (nearest town)			
WELL PURPOSE: (home, irrigation, municipal, industrial)			
WELL COMPLETION DATA:			
(1) diameter (inches) 4			
(2) total depth (feet) 100			
(3) static water level (feet) 50 below top of ground.			
(4) casing PVC 92 (material) (depth)			
4 (size) If telescope see back.			
(5) screen 8 92 (length) (depth to top)			
4 (size) PVC (material)			
(6) pump 1/2 10 (HP) (yield gpm)			
Electric (type power)			
(7) electric log No (yes or no)			
(organization running log)			
(8) how well bottom plugged Sand plug			
DRILLERS REMARKS:			

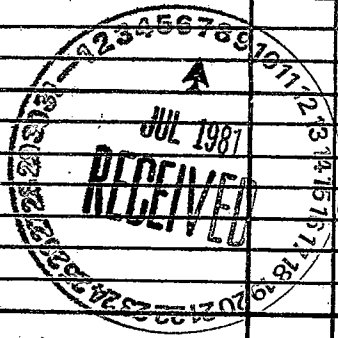

If well telescopes please sketch and show depths.

GROUND LEVEL

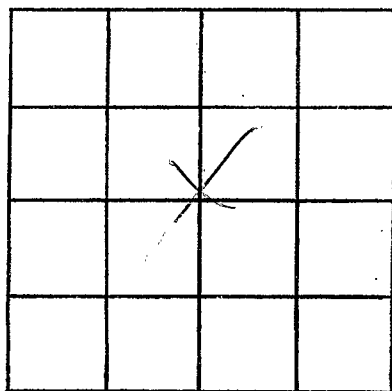

SECTION 11

Please indicate well location X.

ADDITIONAL INFORMATION

If more than one screen,  
show locations of each on sketch.