

Pike
 L 2038
 6-29-81

MISSISSIPPI
 BOARD OF WATER COMMISSIONERS
 416 North State Street
 Jackson, Mississippi 39201


WATER WELL DRILLERS LOG

6-29 1981
 date well completed

Floodwell Inc
 firm name


Pike
 county well located

LANDOWNER:	description of formations encountered	from	to
Rosalind Hardin			
R.R. Magnolia (mailing address)	Red clay Coarse sand & gravel	2 20	20 60
WELL LOCATION:			
sec. 2 T 1 N R 8 E S W			
1 miles W of Allen Bay (distance) (direction) (nearest town)			
WELL PURPOSE:			
(home, irrigation, municipal, industrial)			
WELL COMPLETION DATA:			
(1) diameter (inches) 4			
(2) total depth (feet) 60			
(3) static water level (feet) 20 below top of ground.			
(4) casing PVC 52 (material) (depth)			
4 if telescope see back. (size)			
(5) screen 8 52 (length) (depth to top)			
4 PVC (size) (material)			
(6) pump 1 20 (HP) (yield gpm)			
6kw (type power)			
(7) electric log ne (yes or no)			
(organization running log)			
(8) how well bottom plugged L.P.M.			
DRILLERS REMARKS:			

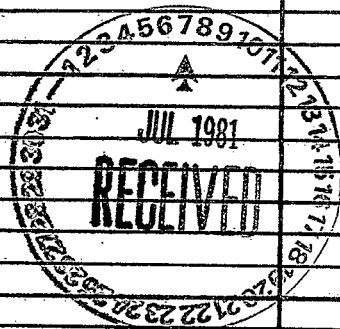

If well telescopes please sketch and show depths.

GROUND LEVEL

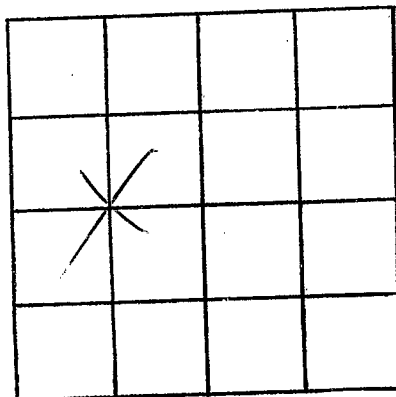

SECTION 2

Please indicate well location X.

ADDITIONAL INFORMATION

If more than one screen,
show locations of each on sketch.