

PIKE  
L 2037  
9-18-81

MISSISSIPPI  
 BOARD OF WATER COMMISSIONERS  
 416 North State Street  
 Jackson, Mississippi 39201


WATER WELL DRILLERS LOG

9-18 1981 F. J. Goodwell Inc Pike  
 date well completed firm name county well located

| LANDOWNER:  | description of formations encountered   | from                                | to                                    |
|---|---|-------------------------------------|---------------------------------------|
| <u>Richard Bryant</u>   |   |                                     |                                       |
| <u>R.R. Ozyka Mrs.</u><br>(mailing address)   | <u>Red clay</u><br><u>Red sand</u><br><u>Coarse sand &amp; gravel</u>                     | <u>0</u><br><u>20</u><br><u>115</u> | <u>20</u><br><u>115</u><br><u>126</u> |
| <b>WELL LOCATION:</b><br>sec. <u>32</u> T. <u>1</u> N. R. <u>8</u> E<br><u>5</u> miles <u>E</u> of <u>Ozyka</u><br>(distance) (direction) (nearest town)  |   |                                     |                                       |
| <b>WELL PURPOSE:</b><br>(home, irrigation, municipal, industrial) <u>Home</u>   |   |                                     |                                       |
| <b>WELL COMPLETION DATA:</b><br>(1) diameter (inches) <u>4</u><br>(2) total depth (feet) <u>126</u><br>(3) static water level (feet) <u>80</u> below above top of ground.<br>(4) casing <u>PVC</u> , <u>118</u> ,<br>(material) (depth)<br><u>4</u> if telescope see back.<br>(size)<br>(5) screen <u>8</u> , <u>118</u><br>(length) (depth to top)<br><u>4</u> , <u>PVC</u><br>(size) (material)<br>(6) pump <u>1/2</u> <u>10</u><br>(HP) (yield gpm)<br><u>elec</u><br>(type power)<br>(7) electric log <u>no</u><br>(organization running log)<br>(8) how well bottom plugged <u>Sand fill</u> |   |                                     |                                       |
| <b>DRILLERS REMARKS:</b>  | DEPT. OF NATURAL RESOURCES<br>BUREAU OF LAND & WATER RESOURCES<br>SEP 20 1981<br>RECEIVED |                                     |                                       |

If well telescopes please sketch and show depths.

GROUND LEVEL

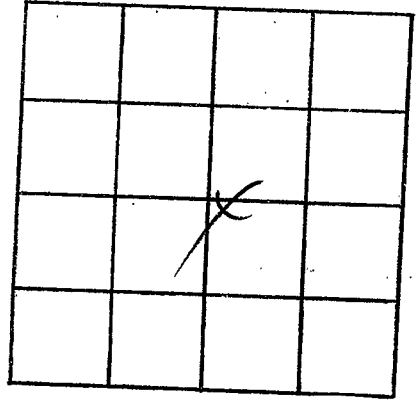

SECTION 32

Please indicate well location X.

ADDITIONAL INFORMATION

If more than one screen,  
show locations of each on sketch.