

MISSISSIPPI DEPARTMENT OF NATURAL RESOURCES
 Bureau of Land and Water Resources
 Southport Mall
 P.O. Box 10631
 Jackson, Mississippi 39209
WATER WELL DRILLERS LOG

13

PIKE
 L 2044
 6/29/81

June 29 1981 Brownsville Pike
 date well completed firm name county well located

LANDOWNER:
Walter Brumfield
Rt Magnolia
 (mailing address)

description of formations encountered	from	to
<u>Red Clay</u>	<u>0</u>	<u>20</u>
<u>sand & gravel</u>	<u>20</u>	<u>25</u>
<u>sandy clay</u>	<u>25</u>	<u>60</u>
<u>Gravel Chalk</u>	<u>60</u>	<u>100</u>
<u>sand</u>		
<u>sand & gravel</u>	<u>100</u>	<u>108</u>

WELL LOCATION:
 sec. 19 T 1 N R 8 E
2 1/2 miles E.NE of Osyka
 (distance) (direction) (nearest town)

WELL PURPOSE: home
 (home, irrigation, municipal, industrial)

- WELL COMPLETION DATA:
- (1) diameter (inches) 4"
 - (2) total depth (feet) 108
 - (3) static water level (feet) 90 below above top of ground
 - (4) casing plastic bottom
 (material) (depth)
 - 7 if telescope see back.
 (size)
 - (5) screen 5 103'
 (length) (depth to top)
 - 6 1/2" plastic
 (size) (material)
 - (6) pump 1/2 10
 (HP) (yield gpm)
 - shot
 (type power)
 - (7) electric log no
 (yes or no)
 - (organization running log)


(8) how well bottom plugged
back wash

DRILLERS REMARKS:

DEPT. OF NATURAL RESOURCES
 BUREAU OF LAND & WATER RESOURCES
 JAN 4 - 1982
RECEIVED

If well telescopes please sketch and show depths.

GROUND LEVEL

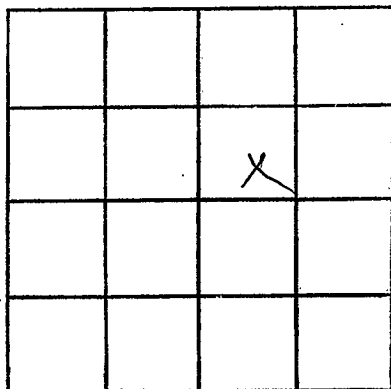

SECTION 19

Please indicate well location X.

ADDITIONAL INFORMATION

If more than one screen, show locations of each on sketch.