

MISSISSIPPI DEPARTMENT OF NATURAL RESOURCES

Bureau of Land and Water Resources

Southport Mall

P.O. Box 10631

Jackson, Mississippi 39209

WATER WELL DRILLERS LOG

PIKE
L
2042

Feb 9 - 1982 Remes Well Co Pike  
 date well completed firm name county well located

LANDOWNER:  
C. B. Terrell  
Rt Magnolia  
 (mailing address)

description of formations encountered	from to	
<u>Red clay</u>	<u>0</u>	<u>24</u>
<u>Red sand</u>	<u>24</u>	<u>65</u>
<u>sand &amp; gravel</u>	<u>65</u>	<u>100</u>
<u>Red chalk</u>	<u>100</u>	<u>109</u>
<u>sand &amp; gravel</u>	<u>105</u>	<u>129</u>

WELL LOCATION:  
 sec. 7 T. 1 N. R. 4 E.  
6 miles South of Magnolia  
 (distance) (direction) (nearest town)

WELL PURPOSE: Domestic  
 (home, irrigation, municipal, industrial)

- WELL COMPLETION DATA:
- (1) diameter (inches) 4"
  - (2) total depth (feet) 129
  - (3) static water level (feet) 100 below top of ground.
  - (4) casing plastic, bottom (material) (depth)
  - (size) if telescope see back.
  - (5) screen 5' 124" (length) (depth to top)
  - (size) (material) 4" plastic
  - (6) pump 1/2 HP plastic (yield gpm)
  - (type power) electric
  - (7) electric log no (yes or no)
  - (organization running log)

(8) How well bottom plugged back wash

DRILLERS REMARKS:


DEPT. OF NATURAL RESOURCES  
 BUREAU OF LAND & WATER RESOURCES

JUL - 1 1982

RECEIVED

If well telescopes please  
sketch and show depths.

GROUND LEVEL

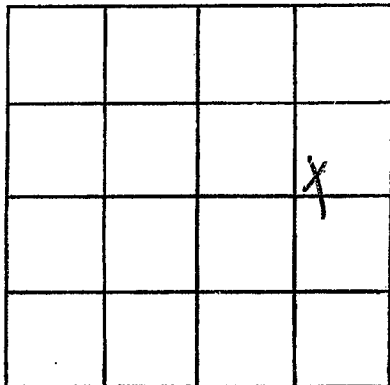

SECTION 2

Please indicate well location X.

ADDITIONAL INFORMATION

If more than one screen,  
show locations of each on sketch.