

MISSISSIPPI DEPARTMENT OF NATURAL RESOURCES

Bureau of Land and Water Resources

Southport Mall

P.O. Box 10631

Jackson, Mississippi 39209

WATER WELL DRILLERS LOG

PIKE
L
2013

July 23 1982 Recess Well in Pike
 date well completed firm name county well located

LANDOWNER: Bernell Knippers
Pt. Magnolia
 (mailing address)

description of formations encountered	from	to
<u>Red Clay</u>	<u>8</u>	<u>18</u>
<u>Red Chalky Sand</u>	<u>18</u>	<u>76</u>
<u>Gravelly Sand</u>	<u>76</u>	<u>91</u>

WELL LOCATION:
 sec. 14 T-1 N R-8 E
3 miles west of Progress
 (distance) (direction) (nearest town)

WELL PURPOSE: house
 (home, irrigation, municipal, industrial)

- WELL COMPLETION DATA:
- (1) diameter (inches) 4"
 - (2) total depth (feet) 91
 - (3) static water level (feet) 65 below top of ground.
 - (4) casing plastic, bottom
 (material) (depth)
 - if telescope see back.
 (size)
 - (5) screen 5', 86'
 (length) (depth to top)
 - 4", Aluminum
 (size) (material)
 - (6) pump 2 1/2 10
 (HP) (yield gpm)
 - 2 1/2
 (type power)
 - (7) electric log no
 (yes or no)
 - (organization running log)

(8) how well bottom plugged
back wash

DRILLERS REMARKS:
—


DEPT. OF NATURAL RESOURCES
 BUREAU OF LAND & WATER RESOURCES

NOV 24 1982

RECEIVED

If well telescopes please sketch and show depths.

GROUND LEVEL

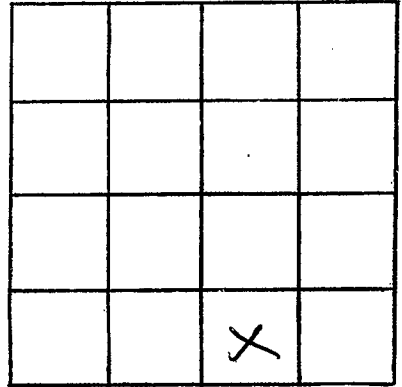

SECTION 14

Please indicate well location X.

ADDITIONAL INFORMATION

If more than one screen,
show locations of each on sketch.