

MISSISSIPPI DEPARTMENT OF NATURAL RESOURCES

Bureau of Land and Water Resources

Southport Mall

P.O. Box 10631

Jackson, Mississippi 39209

WATER WELL DRILLERS LOG

PIKE  
L  
2044

July 13 1992 Acers well on Pike  
date well completed firm name county well located

LANDOWNER:	description of formations encountered	from	to
<u>Jerry Terrell</u> <u>107 Magnolia</u> (mailing address)			
<b>WELL LOCATION:</b>			
sec. <u>7</u> T <u>1</u> N R <u>8</u> E S W			
<u>5 1/2</u> miles <u>South</u> of <u>Magnolia</u> (distance) (direction) (nearest town)			
<b>WELL PURPOSE:</b> <u>private</u> (home, irrigation, municipal, industrial)			
<b>WELL COMPLETION DATA:</b>			
(1) diameter (inches) <u>4"</u>			
(2) total depth (feet) <u>129</u>			
(3) static water level (feet) <u>40</u> below/above top of ground.			
(4) casing <u>plastic, bottom</u> (material) (depth)			
<u>      </u> if telescope see back. (size)			
(5) screen <u>5'</u> <u>120'</u> (length) (depth to top)			
<u>4"</u> <u>plastic</u> (size) (material)			
(6) pump <u>by other</u> (HP) (yield gpm)			
<u>electric</u> (type power)			
(7) electric log <u>no</u> (yes or no)			
<u>      </u> (organization running log)			
(8) how well bottom plugged <u>back wash</u>			
<b>DRILLERS REMARKS:</b>			


DEPT. OF NATURAL RESOURCES  
BUREAU OF LAND & WATER RESOURCES

NOV 24 1992

RECEIVED

If well telescopes please sketch and show depths.

GROUND LEVEL

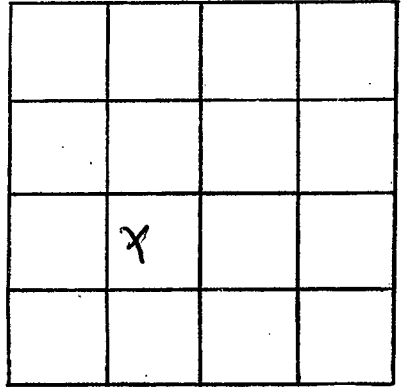

SECTION 7

Please indicate well location X.

ADDITIONAL INFORMATION

If more than one screen, show locations of each on sketch.