

Pike  
L  
2045

MISSISSIPPI  
BOARD OF WATER COMMISSIONERS  
416 North State Street  
Jackson, Mississippi 39201

WATER WELL DRILLERS LOG

8-20 1982 *Fitzgibbon Well Co* *Pike*  
date well completed firm name county well located

LANDOWNER:  
*Emogene Magee*  
*R.R. Oryles, Jr.*  
(mailing address)

description of formations encountered	from	to
<i>Red Clay</i>	<i>0</i>	<i>20</i>
<i>Red-Sandstone</i>	<i>20</i>	<i>115</i>
<i>Coarse Sandstone</i>	<i>115</i>	<i>125</i>

WELL LOCATION:  
sec. *33* T *1* N R *8* E  
S W  
*6* miles *E* of *Oryles*  
(distance) (direction) (nearest town)

WELL PURPOSE: *Flow*  
(home, irrigation, municipal, industrial)

- WELL COMPLETION DATA:
- (1) diameter (inches) *4*
  - (2) total depth (feet) *125*
  - (3) static water level (feet) *60* below above top of ground.
  - (4) casing *PVC*, *117*,  
(material) (depth)  
*4* if telescope see back.  
(size)
  - (5) screen *8*, *117*  
(length) (depth to top)  
*4*, *PVC*  
(size) (material)
  - (6) pump *1/2*, *10*  
(HP) (yield gpm)  
*Elco*  
(type power)
  - (7) electric log *no*  
(yes or no)  
(organization running log)
  - (8) how well bottom plugged *Sealed*

DRILLERS REMARKS:


DEPT. OF NATURAL RESOURCES  
BUREAU OF LAND & WATER RESOURCES

OCT 18 1982

RECEIVED

If well telescopes please sketch and show depths.

GROUND LEVEL

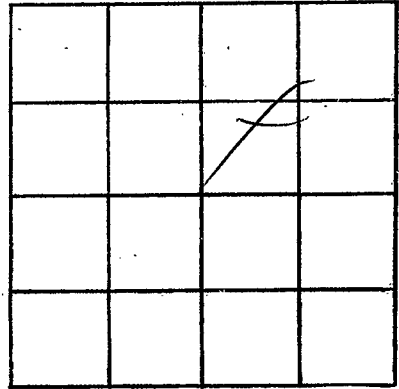

SECTION 33

Please indicate well location X.

ADDITIONAL INFORMATION

If more than one screen, show locations of each on sketch.