

**PIKE**  
L  
2047

MISSISSIPPI DEPARTMENT OF NATURAL RESOURCES  
Bureau of Land and Water Resources  
Southport Mall  
P.O. Box 10631  
Jackson, Mississippi 39209  
**WATER WELL DRILLERS LOG**

Jan 5 1983 Reems Under Pike  
date well completed firm name county well located

**LANDOWNER:**  
Ronald Knight  
Rt Magnolia  
(mailing address)

description of formations encountered	from	to
<u>Clay</u>	<u>0</u>	<u>18</u>
<u>Red Sand</u>	<u>18</u>	<u>85</u>
<u>Sand &amp; gravel</u>	<u>85</u>	<u>96</u>
<u>Chalky Shells</u>	<u>96</u>	<u>130</u>
<u>Sand &amp; gravel</u>	<u>130</u>	<u>140</u>

**WELL LOCATION:**  
sec. 14 T. 1 N R. 8 E  
2 1/2 miles West of Progress  
(distance) (direction) (nearest town)

**WELL PURPOSE:** Trailer  
(home, irrigation, municipal, industrial)


- WELL COMPLETION DATA:**
- (1) diameter (inches) 4"
  - (2) total depth (feet) 140
  - (3) static water level (feet) 90 below top of ground.
  - (4) casing plastic, leather  
(material) (depth)
  - (size) if telescope see back.
  - (5) screen 5' 135'  
(length) (depth to top)
  - 4" plastic  
(size) (material)
  - (6) pump 1/2 other  
(HP) (yield gpm)
  - split  
(type power)
  - (7) electric log no  
(yes or no)
  - (organization running log)
  - (8) how well bottom plugged back wash

**DRILLERS REMARKS:**

DEPT. OF NATURAL RESOURCES  
BUREAU OF LAND & WATER RESOURCES  
APR 27 1983  
**RECEIVED**

If well telescopes please sketch and show depths.

GROUND LEVEL

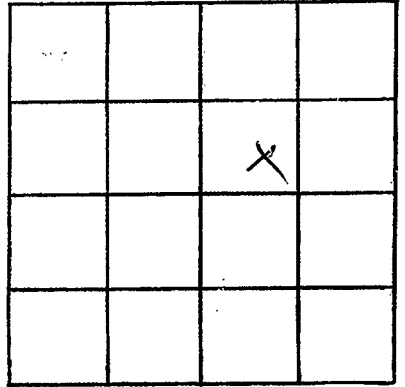

SECTION 14

Please indicate well location X.

ADDITIONAL INFORMATION

If more than one screen, show locations of each on sketch.