

MISSISSIPPI DEPARTMENT OF NATURAL RESOURCES

Bureau of Land and Water Resources

Southport Mall

P.O. Box 10631

Jackson, Mississippi 39209

WATER WELL DRILLERS LOG

Pike
L
2049

May 17 19 1983
 date well completed

Rivers Well Service
 firm name

Pike
 county well located

LANDOWNER:
C. J. Temple
Rt Magnolia
 (mailing address)

description of formations encountered	from	to
<u>Red Clay</u>	<u>0</u>	<u>18</u>
<u>Red sand</u>	<u>18</u>	<u>20</u>
<u>gravel & sand</u>	<u>20</u>	<u>37</u>
<u>lumpy sand</u>	<u>37</u>	<u>140</u>
<u>sand</u>	<u>140</u>	<u>155</u>
<u>gravel & sand</u>	<u>155</u>	<u>163</u>

WELL LOCATION:
 sec. 14 T. 1 N R. 8 E
3 miles West of Progress
 (distance) (direction) (nearest town)

WELL PURPOSE: Home
 (home, irrigation, municipal, industrial)

- WELL COMPLETION DATA:
- (1) diameter (inches) 4"
 - (2) total depth (feet) 163
 - (3) static water level (feet) 80 below top of ground.
 - (4) casing plastic bottom
 (material) (depth)
 - (5) screen 10' 153
 (length) (depth to top)
 - (6) pump 3/8" sub 12
 (size) (material) (yield gpm)
 - (7) electric log no
 (yes or no)
 - (8) how well bottom plugged back wash
 (organization running log)

DRILLERS REMARKS:
back wash


DEPT. OF NATURAL RESOURCES
 BUREAU OF LAND & WATER RESOURCES

JUL 5 1983

RECEIVED

If well telescopes please sketch and show depths.

GROUND LEVEL

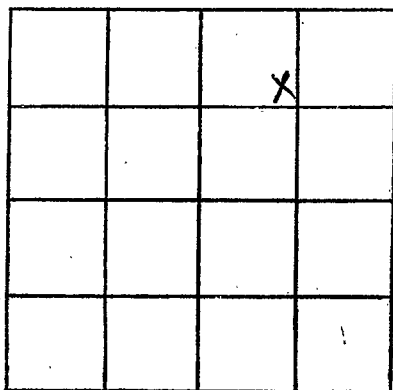

SECTION 14

Please indicate well location X.

ADDITIONAL INFORMATION

If more than one screen, show locations of each on sketch.