

PIKE
L
2050

MISSISSIPPI
BOARD OF WATER COMMISSIONERS
416 North State Street
Jackson, Mississippi 39201

WATER WELL DRILLERS LOG

8-1
date well completed

1983

Fitzgerald Sew
firm name

Pike
county well located

LANDOWNER:	description of formations encountered	from	to
Otis Kennedy R.B. Magnolia Dr. (mailing address)			
WELL LOCATION:			
sec. 3 T 1 N R 8 E S W			
5 miles WNW of Progress (distance) (direction) (nearest town)			
WELL PURPOSE: Home (home, irrigation, municipal, industrial)			
WELL COMPLETION DATA:			
(1) diameter (inches) 4			
(2) total depth (feet) 127			
(3) static water level (feet) 55 below above top of ground.			
(4) casing PVC, 119, (material) (depth) 4 (size) If telescope see back.			
(5) screen 8, 119 (length) (depth to top) 4, PVC (size) (material)			
(6) pump 1/2, 16 (HP) (yield gpm) Clus (type power)			
(7) electric log No (yes or no)			
(8) how well bottom plugged Seal (organization running log)			
DRILLERS REMARKS:			


DEPT. OF NATURAL RESOURCES
BUREAU OF LAND & WATER RESOURCES

AUG 15 1983

RECEIVED

If well telescopes please sketch and show depths.

GROUND LEVEL

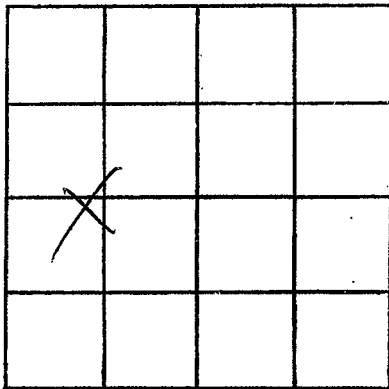

SECTION 3

Please indicate well location X.

ADDITIONAL INFORMATION

If more than one screen, show locations of each on sketch.