

MISSISSIPPI DEPARTMENT OF NATURAL RESOURCES

Bureau of Land and Water Resources

Southport Mall

P.O. Box 10631

Jackson, Mississippi 39209

WATER WELL DRILLERS LOG

PIKE  
L  
2053

8-16  
date well completed

1984  
firm name

Pike  
county well located

LANDOWNER:

Sam Taylor

P.O. Osyka, miss.  
(mailing address)

description of formations encountered

from

to

<u>Red Clay</u>	<u>0</u>	<u>20</u>
<u>Red Sand</u>	<u>20</u>	<u>110</u>
<u>Coarse Sand &amp; gravel</u>	<u>110</u>	<u>125</u>

WELL LOCATION:

sec. 4 T 1 N R 8 E  
S W  
5 miles NE of Osyka  
(distance) (direction) (nearest town)

WELL PURPOSE:

Home  
(home, irrigation, municipal, industrial)

WELL COMPLETION DATA:

- (1) diameter (inches) 4
- (2) total depth (feet) 125
- (3) static water level (feet) 62 below above top of ground.
- (4) casing PVC 117  
(material) (depth)  
4 If telescope see back.  
(size)
- (5) screen 8 117  
(length) (depth to top)  
4 PVC  
(size) (material)
- (6) pump 1/2 10  
(HP) (yield gpm)  
elec  
(type power)
- (7) electric log no  
(yes or no)  
(organization running log)
- (8) how well bottom plugged Lead

SEPT. OF NATURAL RESOURCES  
BUREAU OF LAND & WATER RESOURCES


AUG 23 1984

RECEIVED

DRILLERS REMARKS:

If well telescopes please sketch and show depths.

GROUND LEVEL

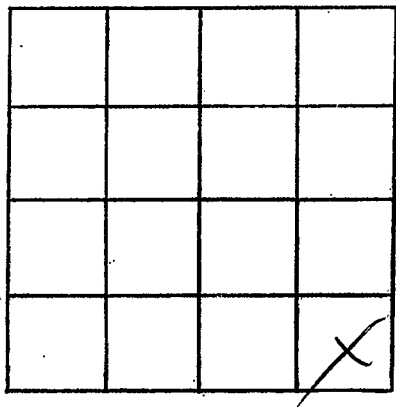

SECTION 4

Please indicate well location X.

ADDITIONAL INFORMATION

If more than one screen, show locations of each on sketch.