

MISSISSIPPI DEPARTMENT OF NATURAL RESOURCES

Bureau of Land and Water Resources

Southport Mall

P.O. Box 10631

Jackson, Mississippi 39209

WATER WELL DRILLERS LOG

PIKE
L
2054

10-4 1984 Fitzgerald well serv Pike  
 date well completed firm name county well located

LANDOWNER: Charlatta Johnson  
RR. Osyka, ms.  
 (mailing address)

description of formations encountered	from	to
<u>Red clay</u>	<u>0</u>	<u>20</u>
<u>Red sand</u>	<u>20</u>	<u>90</u>
<u>Coarse sand &amp; gravel</u>	<u>90</u>	<u>110</u>

WELL LOCATION:  
 sec. 29 T 1 N R 8 E  
                                 S                W  
3 miles E of Osyka  
 (distance) (direction) (nearest town)

WELL PURPOSE: Home  
 (home, irrigation, municipal, industrial)

- WELL COMPLETION DATA:
- (1) diameter (inches) 4
  - (2) total depth (feet) 110
  - (3) static water level (feet) 40 below above top of ground.
  - (4) casing PVC, 102,  
 (material) (depth)  
4  
 (size) if telescope see back.
  - (5) screen 8, 102,  
 (length) (depth to top)  
4,  
 (size) (material)
  - (6) pump 1/2, 10,  
 (HP) (yield gpm)  
elm  
 (type power)
  - (7) electric log no  
 (yes or no)  
S  
 (organization running log)
  - (8) how well bottom plugged Sand plug


DRILLERS REMARKS:

DEPT. OF NATURAL RESOURCES  
 BUREAU OF LAND & WATER RESOURCES

DEC - 4 1984  
 RECEIVED

If well telescopes please sketch and show depths.

GROUND LEVEL

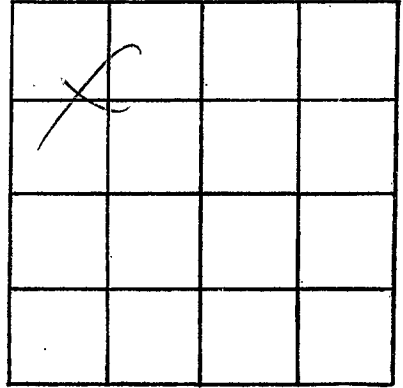

SECTION 29

Please indicate well location X.

ADDITIONAL INFORMATION

If more than one screen,  
show locations of each on sketch.