

MISSISSIPPI DEPARTMENT OF NATURAL RESOURCES

Bureau of Land and Water Resources

Southport Mall

P.O. Box 10631

Jackson, Mississippi 39209

WATER WELL DRILLERS LOG

PIKE
L 2055

12-24 1984
date well completed

Heilabel Law
firm name

Pike
county well located

LANDOWNER:
Bill Fournet
R.R. 205KA
W. R. ...
(mailing address)

description of formations encountered	from	to
<u>Red clay</u>	<u>0</u>	<u>20</u>
<u>Red dirt</u>	<u>25</u>	<u>90</u>
<u>Coarse sandstone</u>	<u>90</u>	<u>120</u>

WELL LOCATION:
sec. 10 T-1 N R-8 E
S W
1 miles E of BALL
(distance) (direction) (nearest town)

WELL PURPOSE: Home
(home, irrigation, municipal, industrial)


- WELL COMPLETION DATA:
- (1) diameter (inches) 4
 - (2) total depth (feet) 120
 - (3) static water level (feet) 40 below top of ground.
 - (4) casing 4" PVC 112'
(material), (depth)
4" if telescope see back.
(size)
 - (5) screen 8" 112'
(length), (depth to top)
4", PVC
(size), (material)
 - (6) pump 1/2 10
(HP) (yield gpm)
Electric
(type power)
 - (7) electric log yes
(yes or no)
(organization running log)
 - (8) how well bottom plugged plugged

DRILLERS REMARKS:

Handwritten notes:
1-7-84

If well telescopes please sketch and show depths.

GROUND LEVEL

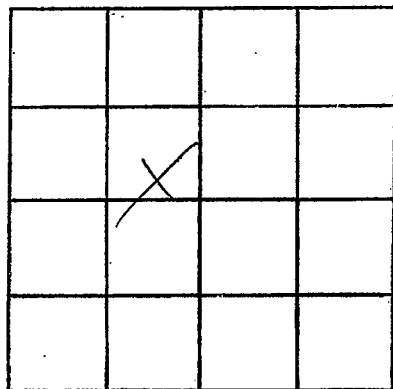

SECTION 16

Please indicate well location X.

ADDITIONAL INFORMATION

If more than one screen,
show locations of each on sketch.